


T27S R14W
NE 1/4 of Sec. 16

RECEIVED
JUL 6 1983
WATER RESOURCES DEPT.
SALEM, OREGON

9 10
16 15

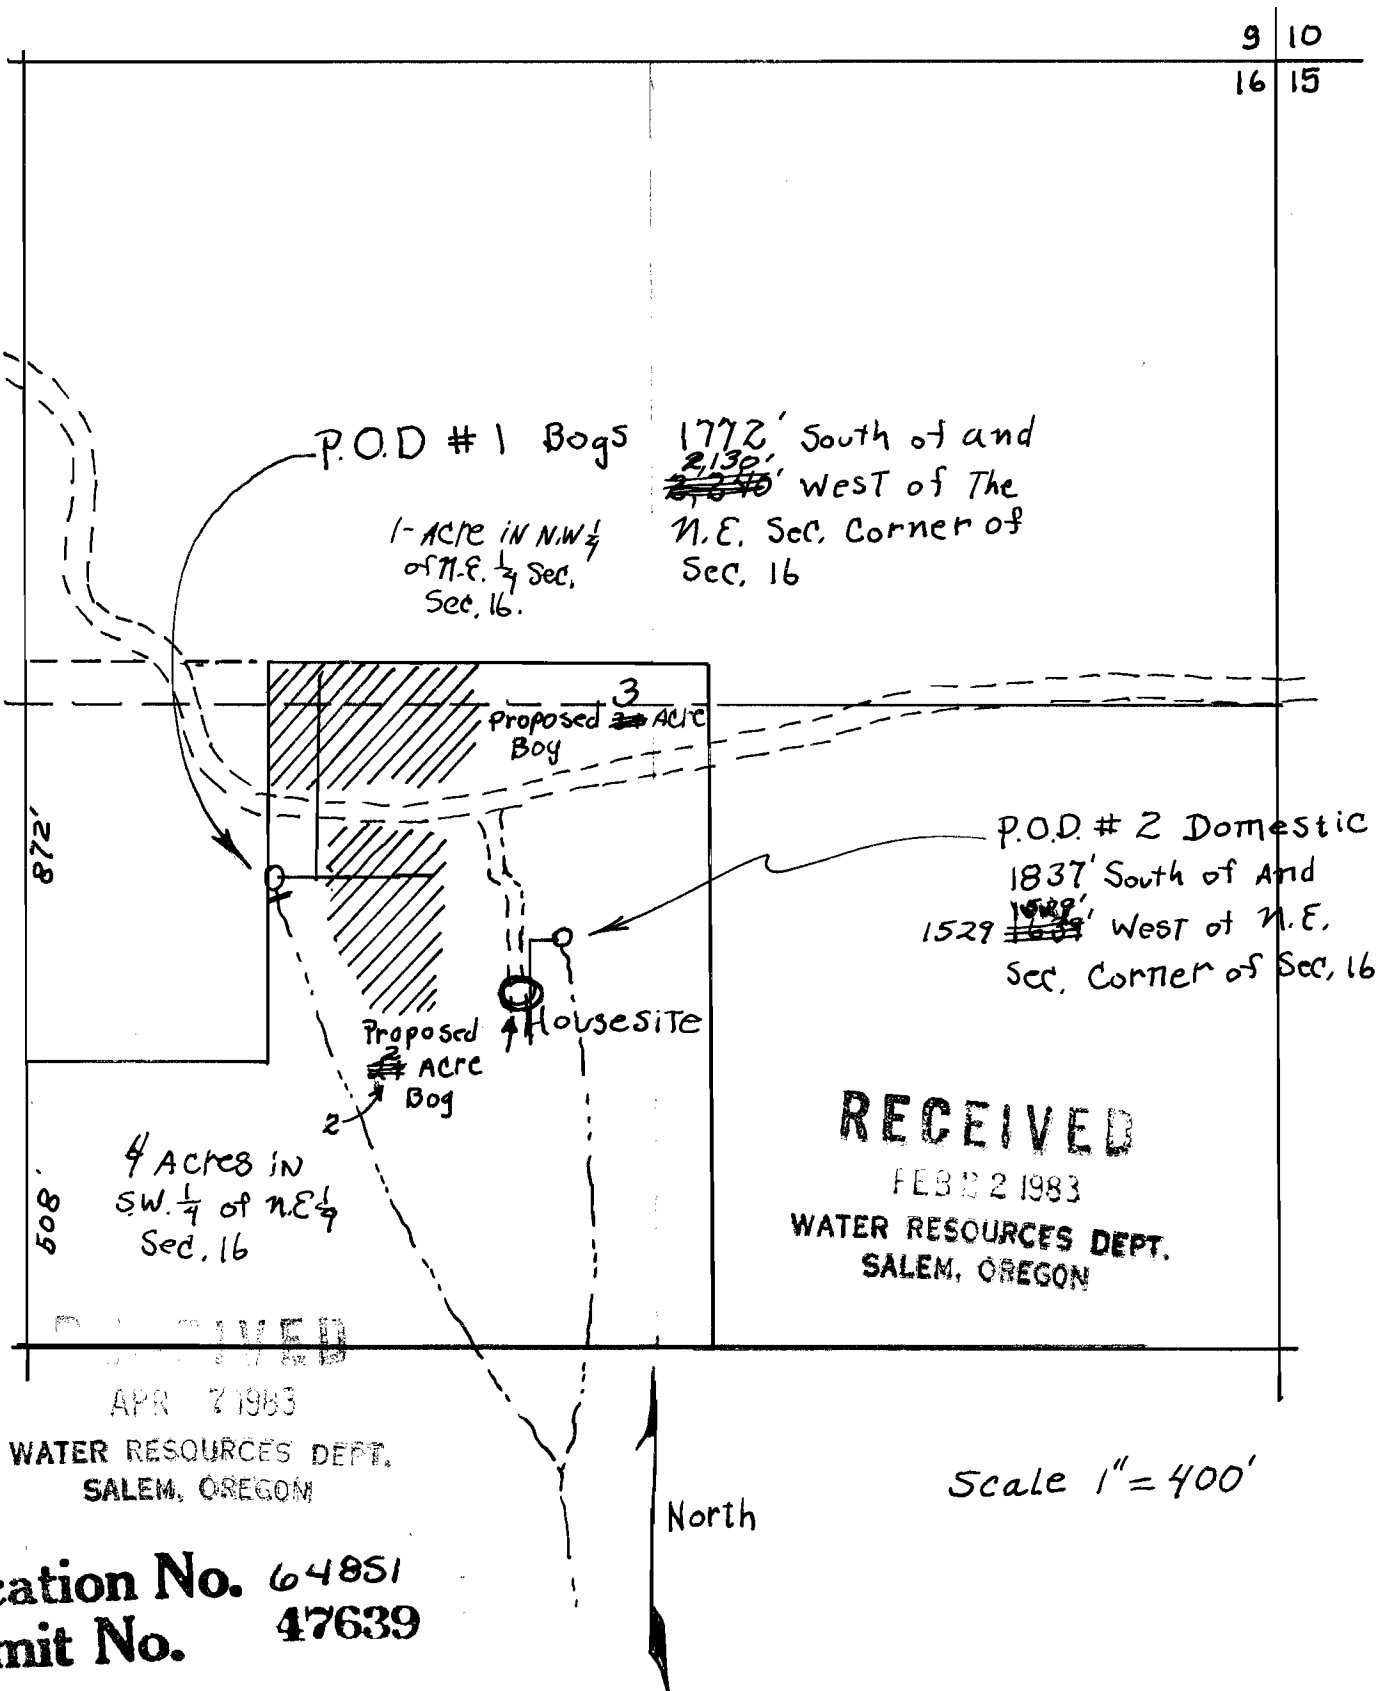

Application No. 64851
Permit No. 47639