


# T. 1 S., R. 38 E., W. M.



*copy*

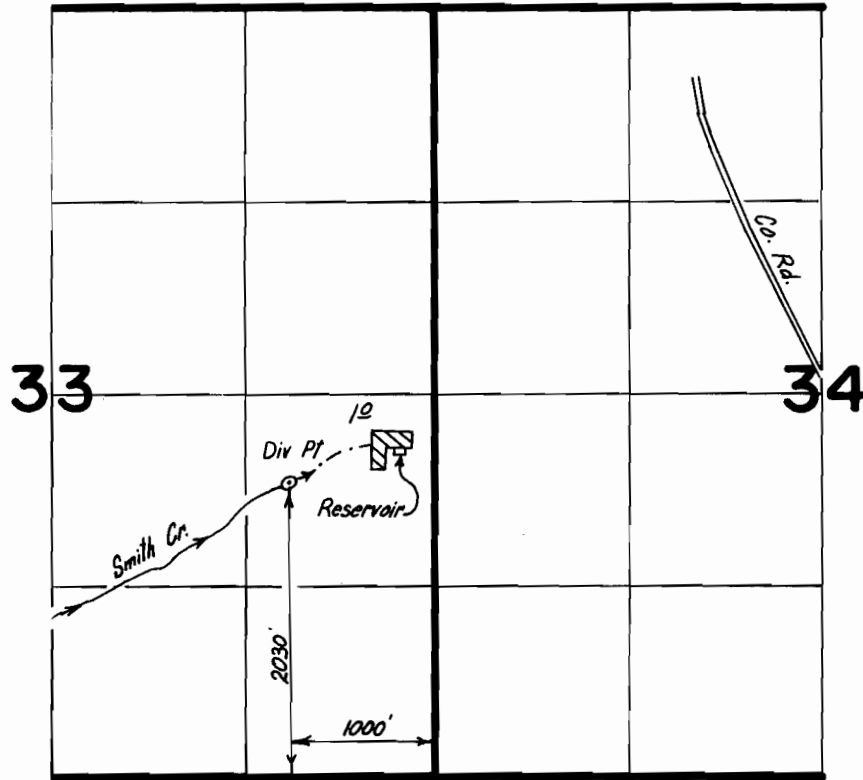

Scale: 1" = 1320'

## FINAL PROOF SURVEY UNDER

R-65015                      R-8810  
 Application No. 65173... Permit No. 47732.....  
 IN NAME OF

GEORGE A. WALKER, GEORGE R. WALKER & LULA FAY WALKER

Surveyed ...9-22... 1987., by ..Vern..Church.....