


T.1S., R.38E., W.M.

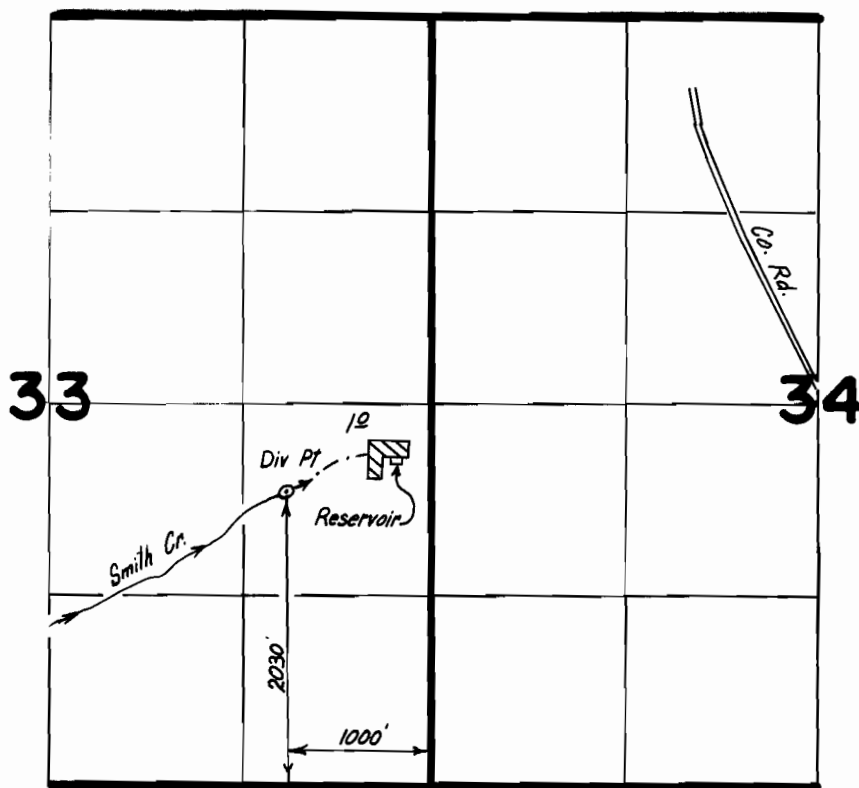

Scale: 1" = 1320'

FINAL PROOF SURVEY

UNDER

R-65015 R-8810
 Application No. 65173..... Permit No. 47732.....
 IN NAME OF

GEORGE A. WALKER, GEORGE R. WALKER & LULA FAY WALKER

Surveyed9-22.... 1987., by ..Vern. Church.....