


T. 29 S., R. 4 W., W.M.

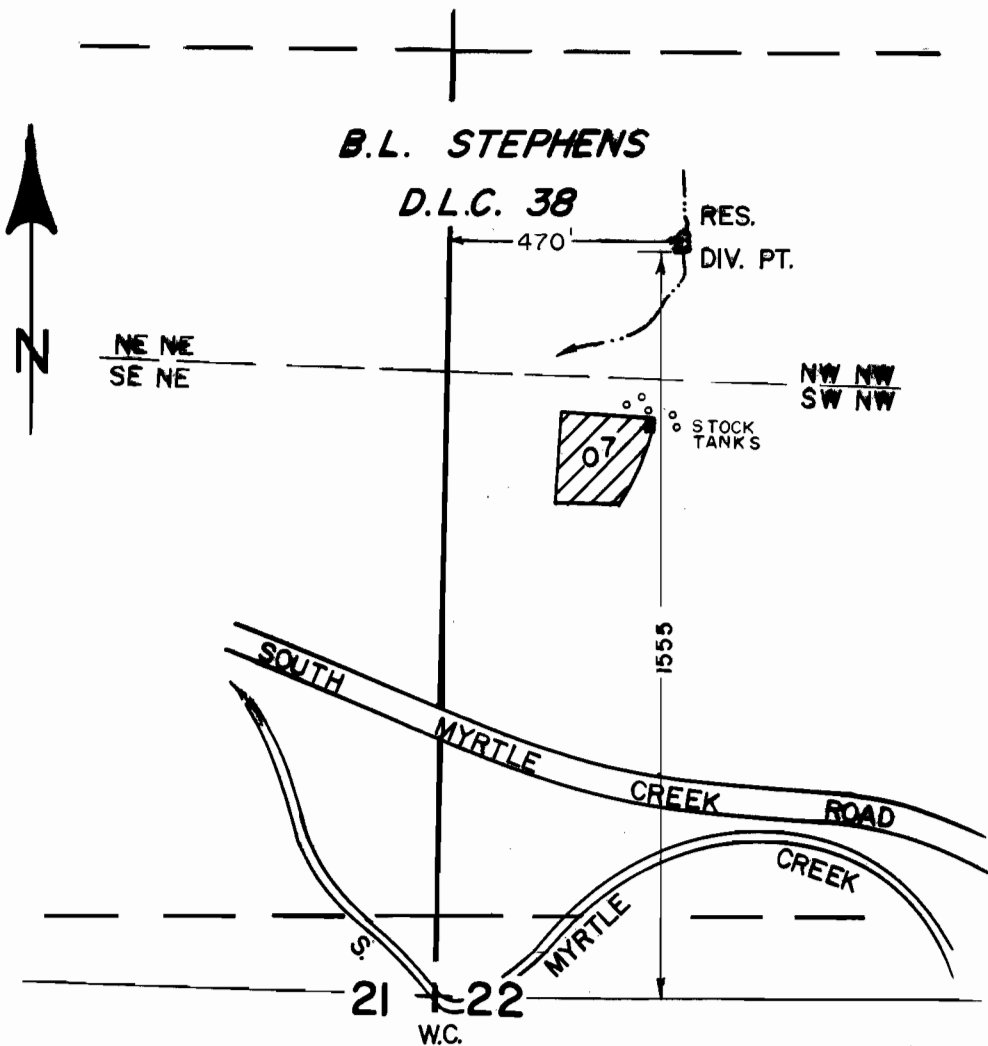

SCALE : 1" = 400'

FINAL PROOF SURVEY
UNDER

R-67520 R-9387
Application No. 67521... Permit No. 48250.....
IN NAME OF

MILFORD B. BATES & MARY K. BATES

Surveyed MAY 7, 19 86, by J.M. SCHMORDE