


T. 6S., R. 1W., W.M.

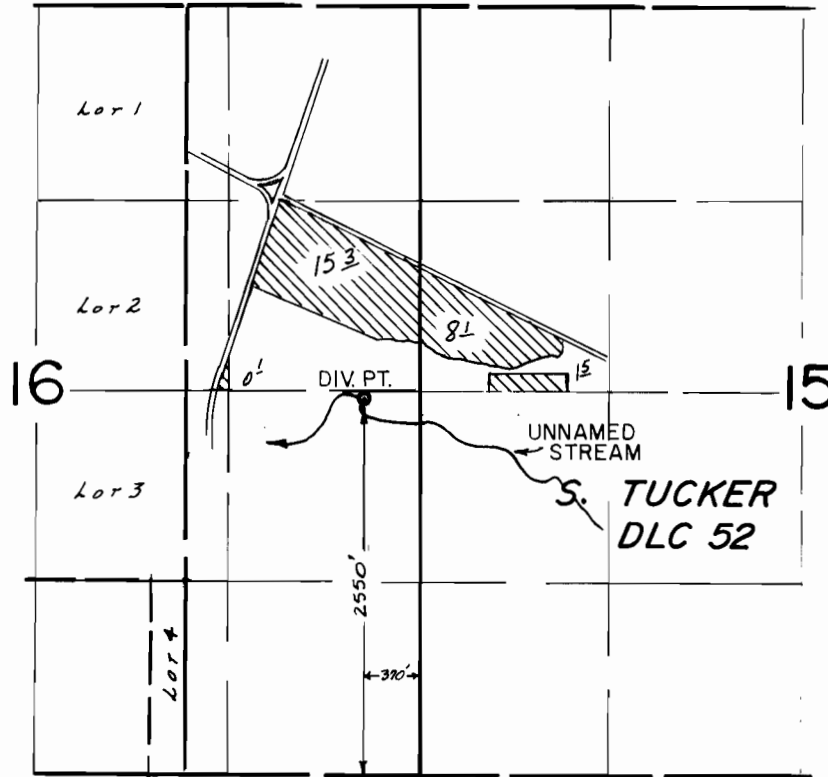

SCALE: 1" = 1320'

FINAL PROOF SURVEY UNDER

Application No. 68071..... Permit No. 48484.....

IN NAME OF

RONALD G. BUHR

Surveyed AUG. 30 19.85, by B. W. BISHOP