


SEC. 1
T. 27 S., R. 13 W., W.M.

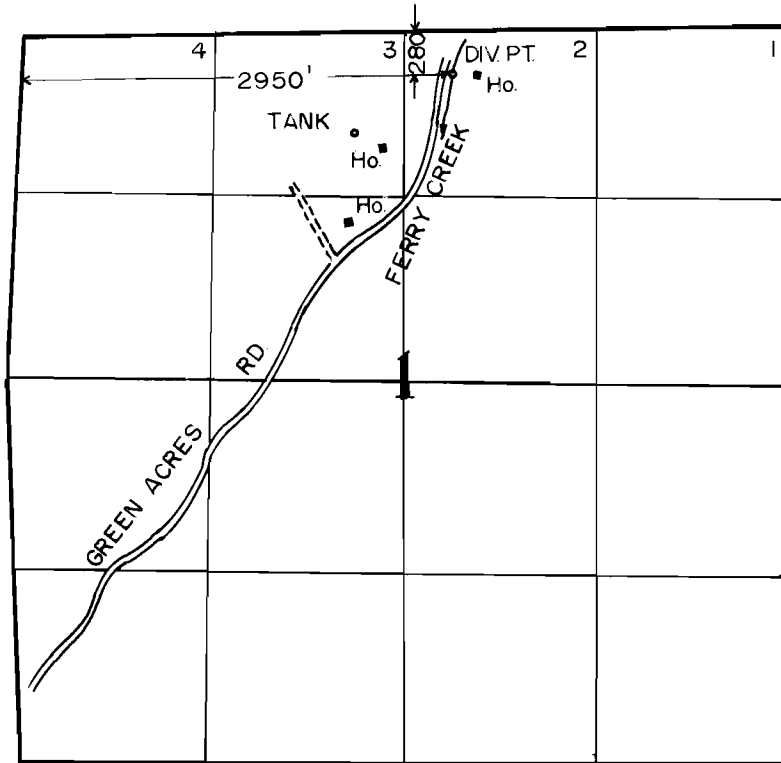

N
1" = 1320'

FINAL PROOF SURVEY
UNDER

Application No. 68391..... Permit No. 49454.....
IN NAME OF
ARTHUR W. & GOLDIE M. BUTTON

Surveyed SEPT. 18. 19.90., by B. W. BISHOP.....

1- 22 - 91
41011-180-194R