


T. 1 S., R. 4 E., W.M.

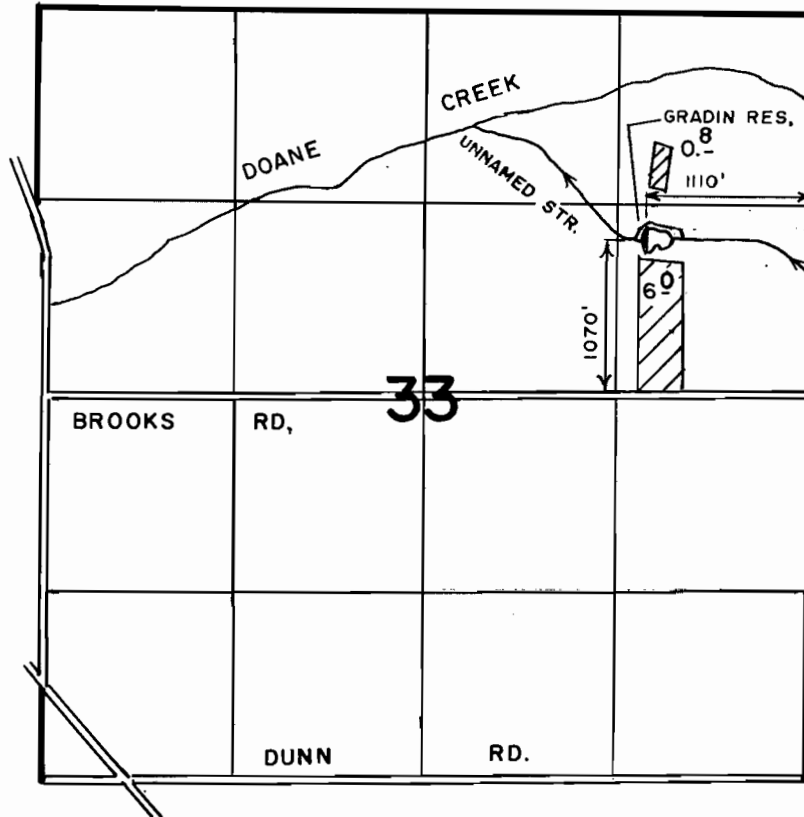

1" = 1320'

FINAL PROOF SURVEY UNDER

R-68423 R-10620
Application No. 68424 Permit No. 49670
IN NAME OF

RODNEY N. GRADIN

Surveyed MAY 3, 1990, by T.M. WARREN