


# T.23S., R.7W., W.M.

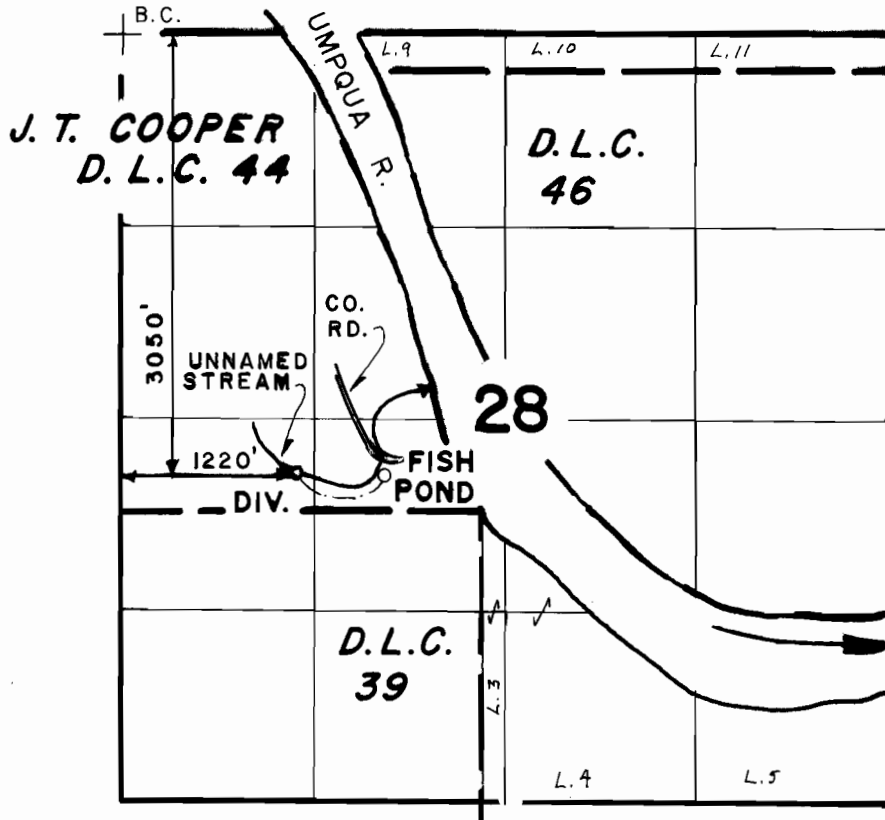

SCALE: 1" = 1320'

## FINAL PROOF SURVEY UNDER

Application No. 68558... Permit No. 49589.....  
IN NAME OF

.....**RONALD H. GOURLEY**.....

Surveyed AUG 28 1986, by J. KAUPPILA.....