


T. 9 S. R. 39 E. W.M.

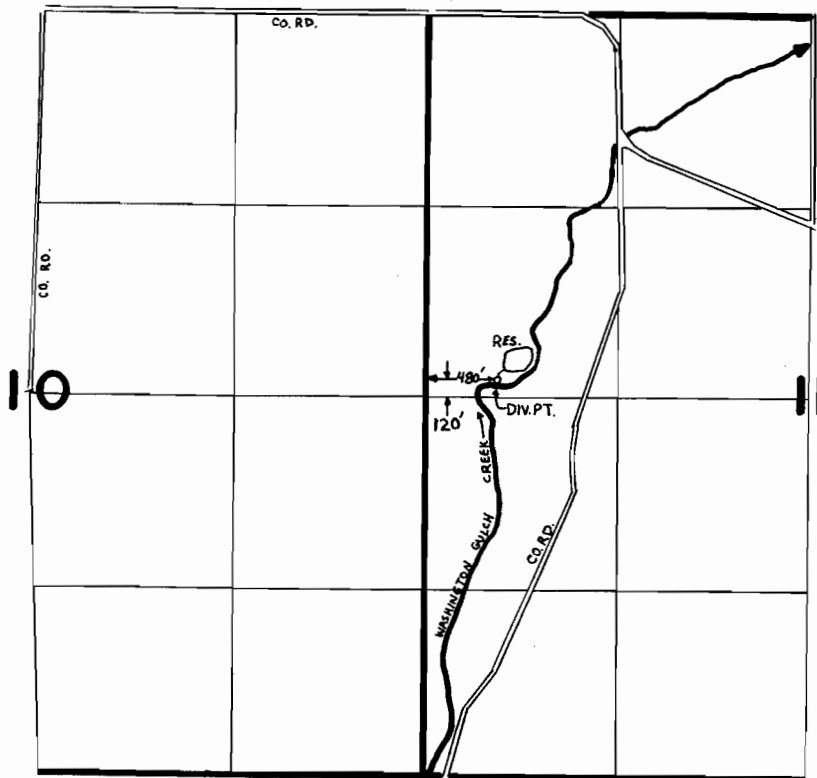

Scale 1"=1320'



FINAL PROOF SURVEY UNDER

R-68580 R-10616
 Application No. 68625... Permit No. 49646.....
 IN NAME OF

.....**CLARENCE E. GREEN**.....

Surveyed March..15. 1987., by V. Church.....