



# T. 9 S. R. 39 E. W.M.

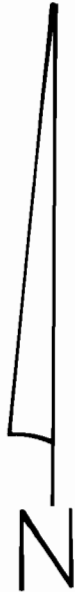

Scale 1"=1320'

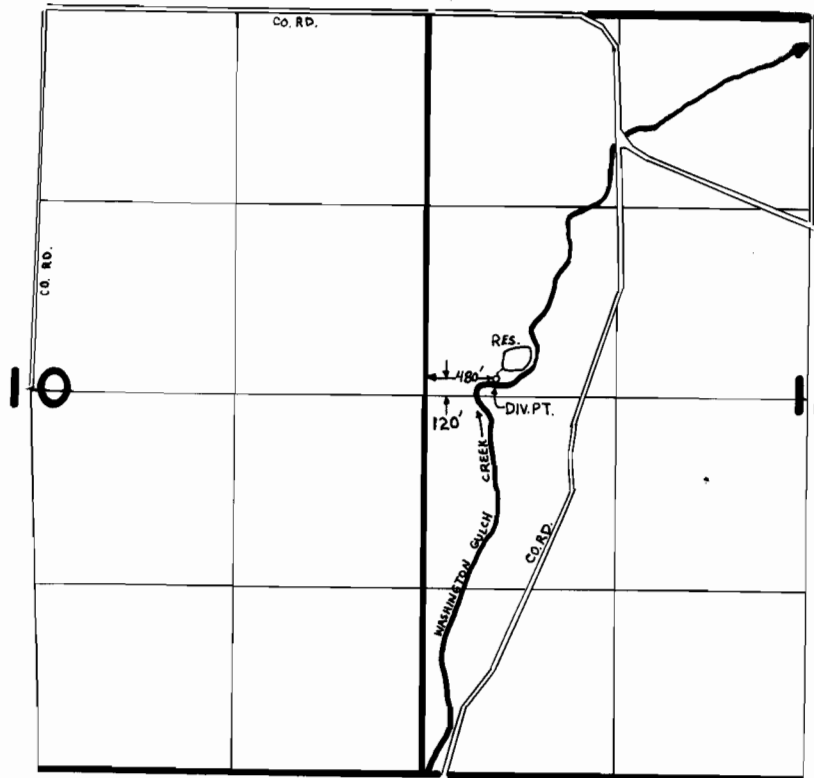

## FINAL PROOF SURVEY UNDER

R-68580                      R-10616  
 Application No. 68625... Permit No. 49646.....  
 IN NAME OF

.....CLARENCE E. GREEN.....

Surveyed March 15, 1987., by V. Church.....