


T. 35 S., R. 7 W., W. M.

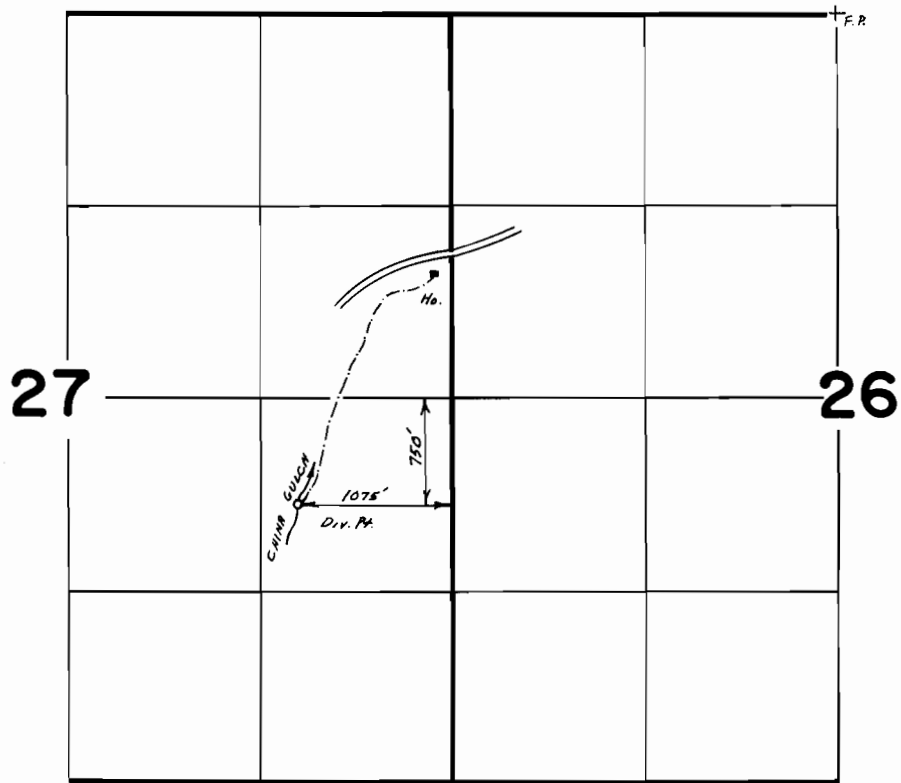

Scale 1" = 400'

FINAL PROOF SURVEY
UNDER

Application No. 68601... Permit No. 49560.....
IN NAME OF

MARY G. THOMAS.....

Surveyed Oct. 29, 1987, by B.S. JAMES.....