
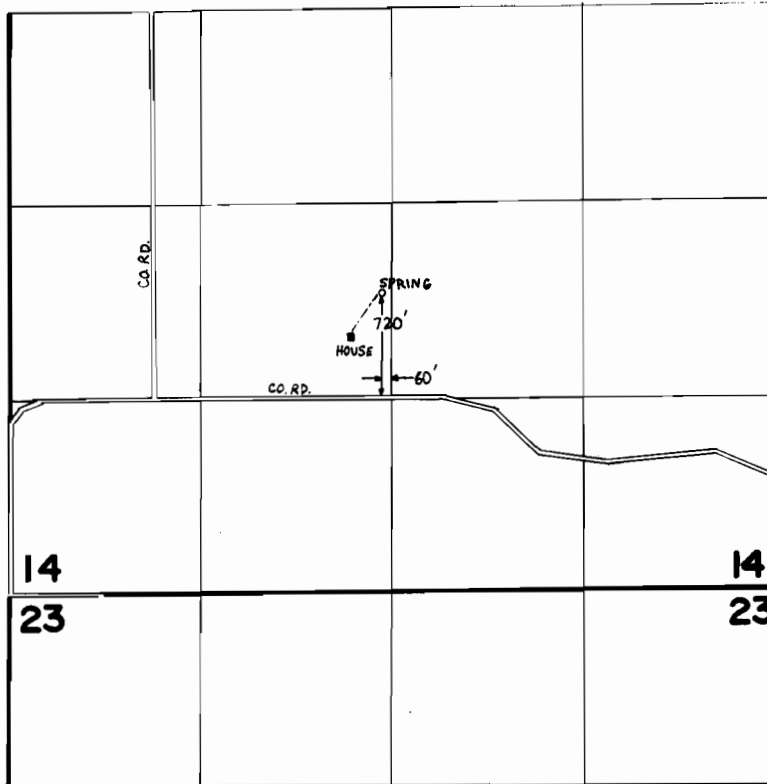


T. 3 S. R. 40 E. W.M.

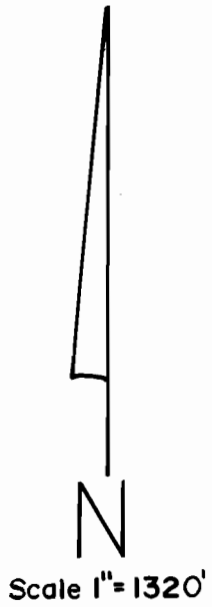

FINAL PROOF SURVEY UNDER

Application No. 687.7.6. Permit No. 4989).....
IN NAME OF

.....TERRY & JAYNE PUCKETT.....

Surveyed April...14. 1987., by V. Church.....