


T. 7 S., R. 39 E., W.M.

UNION PACIFIC

R. R.
KELSEY-WILSON DITCH
TO SECTION 10

KELSEY-WILSON DITCH

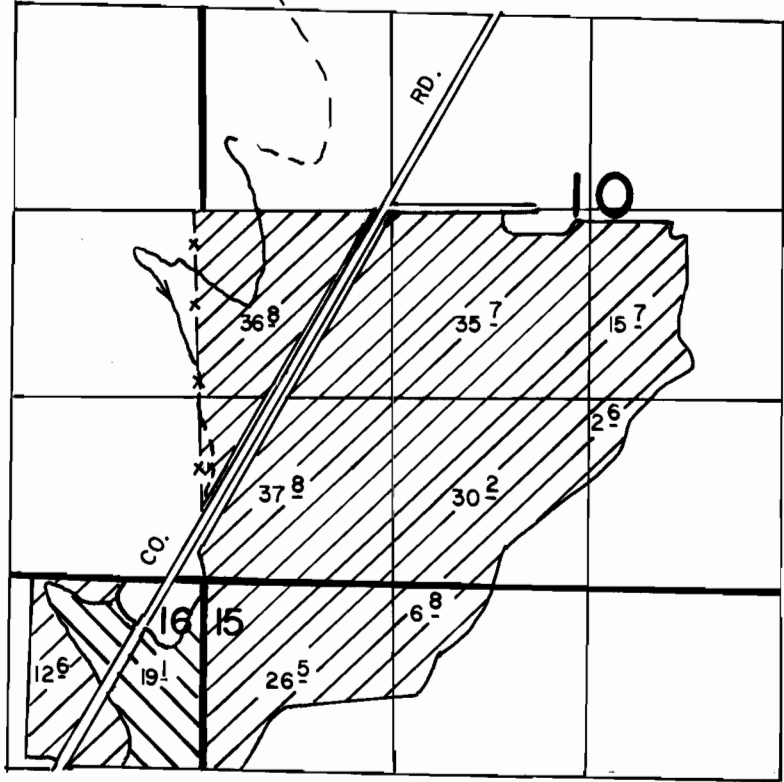

**FINAL PROOF SURVEY
UNDER**

Application No. 68786. Permit No. 49893.....
IN NAME OF

JOHN INMAN

Surveyed FEB. 14. 19.90, by V.L. CHURCH.

4-3-90 DSM
41001-279-84R
41001-279-83L