


T. 30S., R. 5W., W.M. SECTION 5

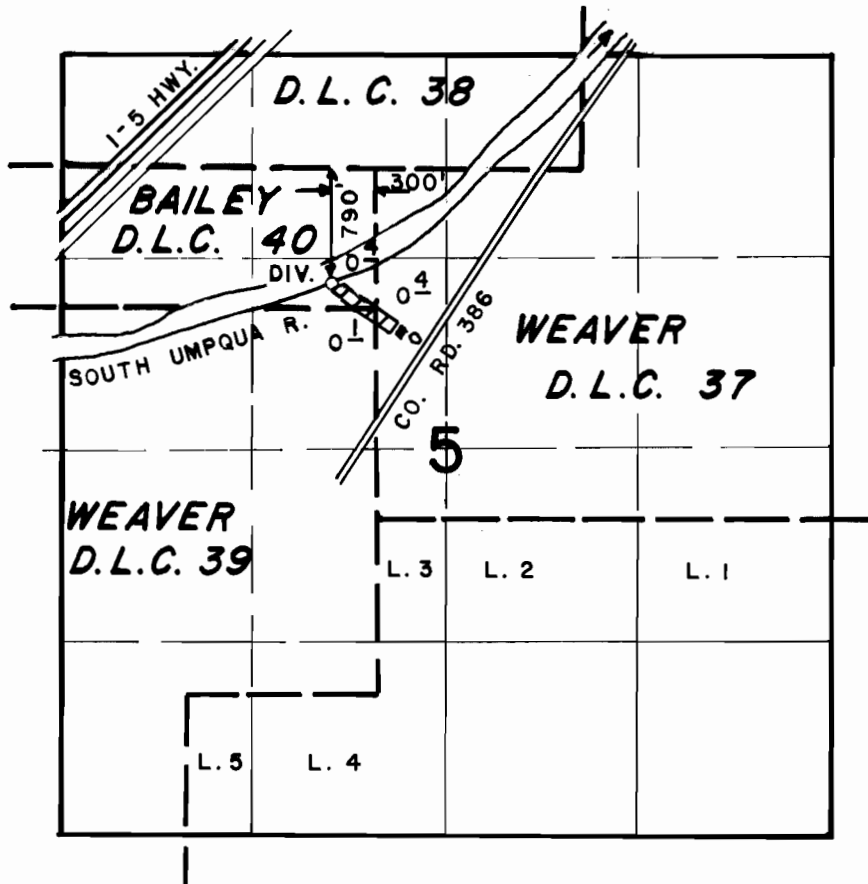

SCALE: 4" = 1 MILE

FINAL PROOF SURVEY UNDER

Application No. 68834 Permit No. 49866
IN NAME OF

HAROLD C. STEVENSON

Surveyed JULY 9, 1987, by J.M. SCHMORDE