


T.21S., R.5W., W.M.

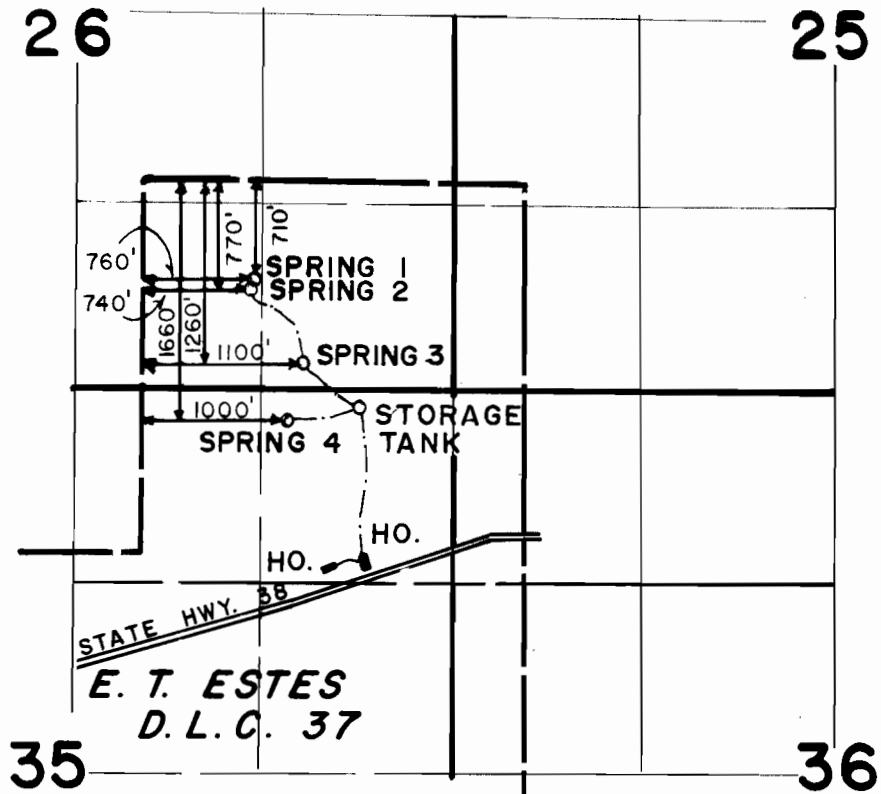

SCALE: 4" = 1 MILE

FINAL PROOF SURVEY
UNDER

Application No. ~~68859~~. Permit No. 49879.....
IN NAME OF

E. D. BREIER & INA BREIER

Surveyed OCT. 15. 19.87, by J.M. SCHMORDE