


T.13S.,R.16E.,W.M.

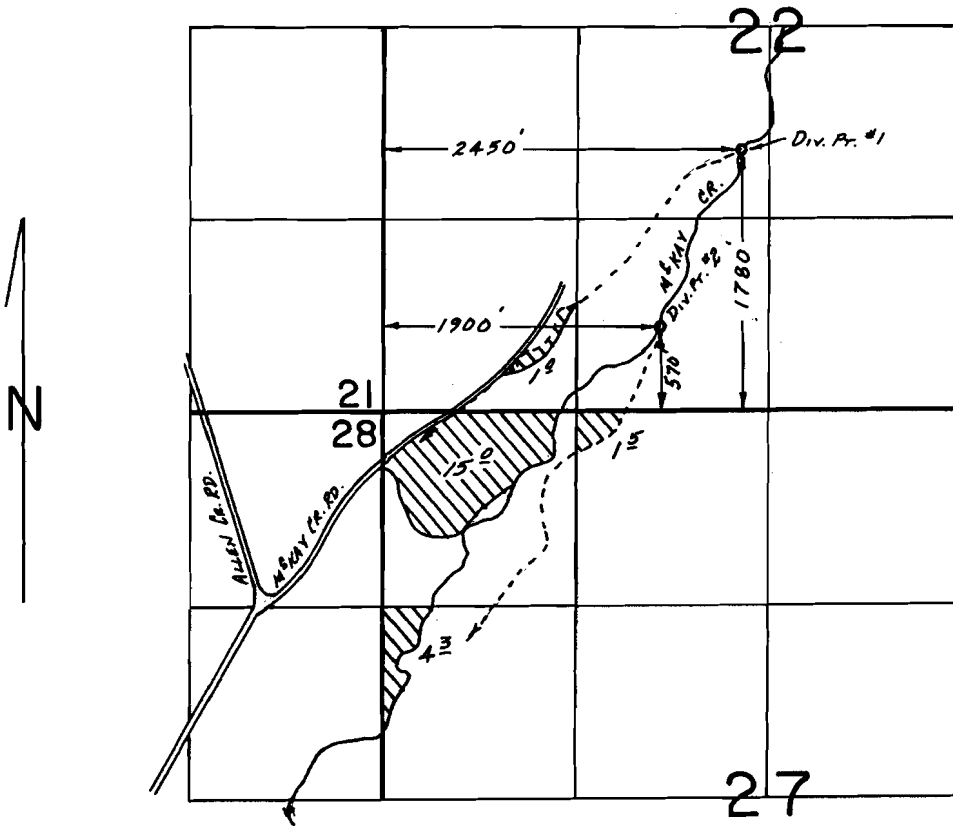

SCALE: 1"=1320'

FINAL PROOF SURVEY
UNDER

Application No. 69086. Permit No. 49996.....
IN NAME OF

Cert. 66290

..... J. DOUG DUNN

Surveyed Aug. 25. 19.87., by M. J. MATTICK.....

Rec'd 7-5-91 WJD# 11