


RECEIVED

AUG 20 1990

T.14S.R.4W.W.M.

WATER RESOURCES DEPT.  
SALEM, OREGON

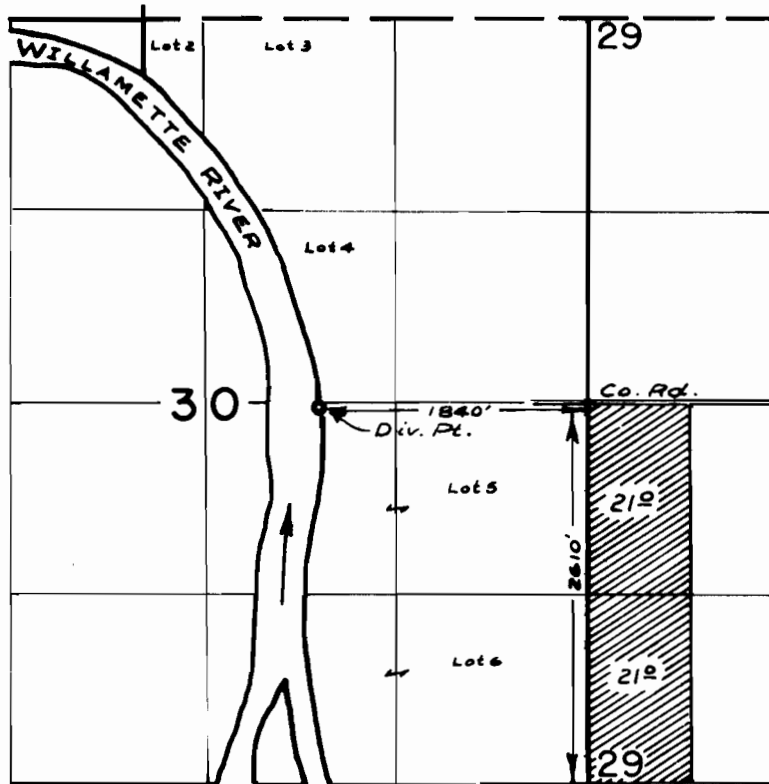

Scale 1" = 1320'

CLAIM OF BENEFICIAL USE  
UNDER APPLIC.No.69885 PER.No. 50724  
IN NAME OF

LARRY C. KROPF

THE PREPARATION OF THIS MAP IS FOR THE  
PURPOSE OF IDENTIFYING THE LOCATION  
OF THE WATER RIGHT ONLY AND HAS NO  
INTENT TO PROVIDE DIMENSIONS OR LOCATION  
OF PROPERTY OWNERSHIP LINES.

