


T. 1 S., R. 2 W., W.M.

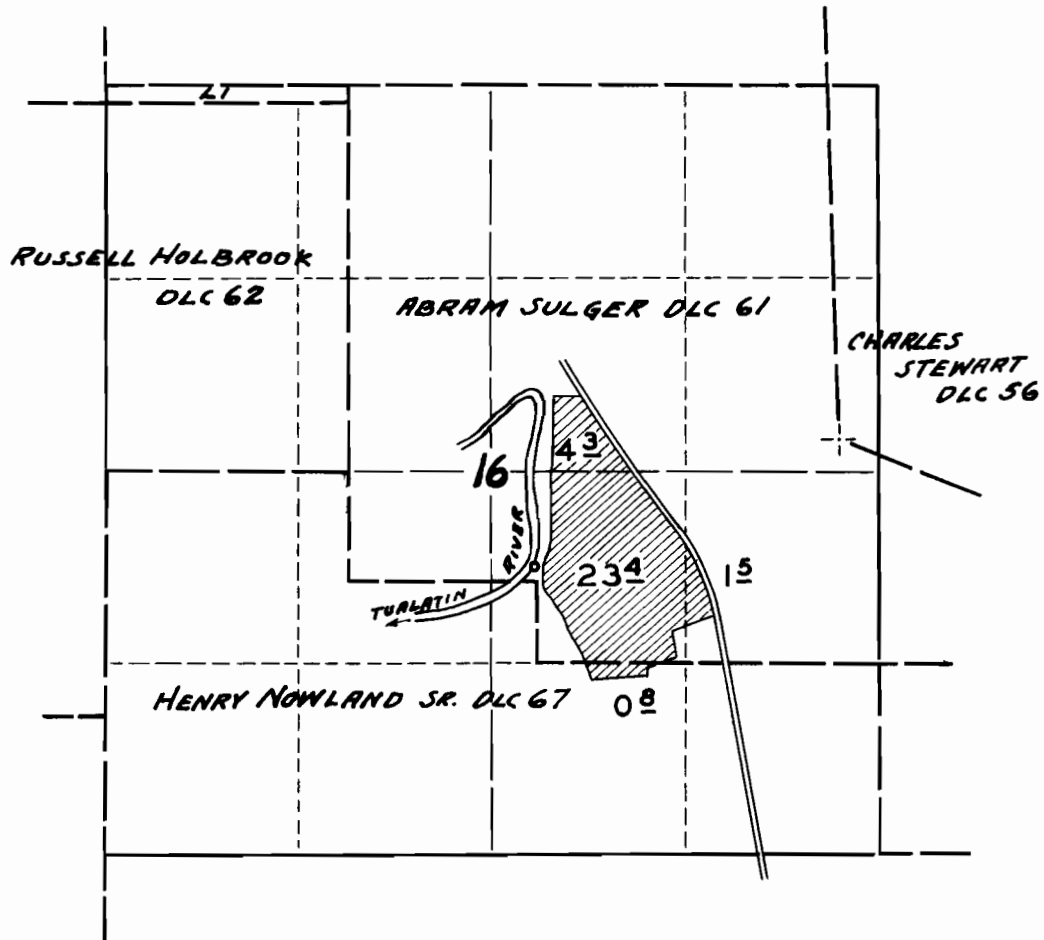

FINAL PROOF SURVEY

UNDER

Application No. 27985 Permit No. 22028

IN NAME OF

JOHN AMREIN

Surveyed 4 - 18 1956, by M. BISH