

Form A1-187
March 1961

UNITED STATES
DEPARTMENT OF THE INTERIOR
BUREAU OF LAND MANAGEMENT

SECTION

5


Oregon State Water Filings

 $NE \frac{1}{4} SE \frac{1}{4}$

TOWNSHIP 30 S, RANGE 42 E, W. M.

SCALE 8" = 1 MI.

North

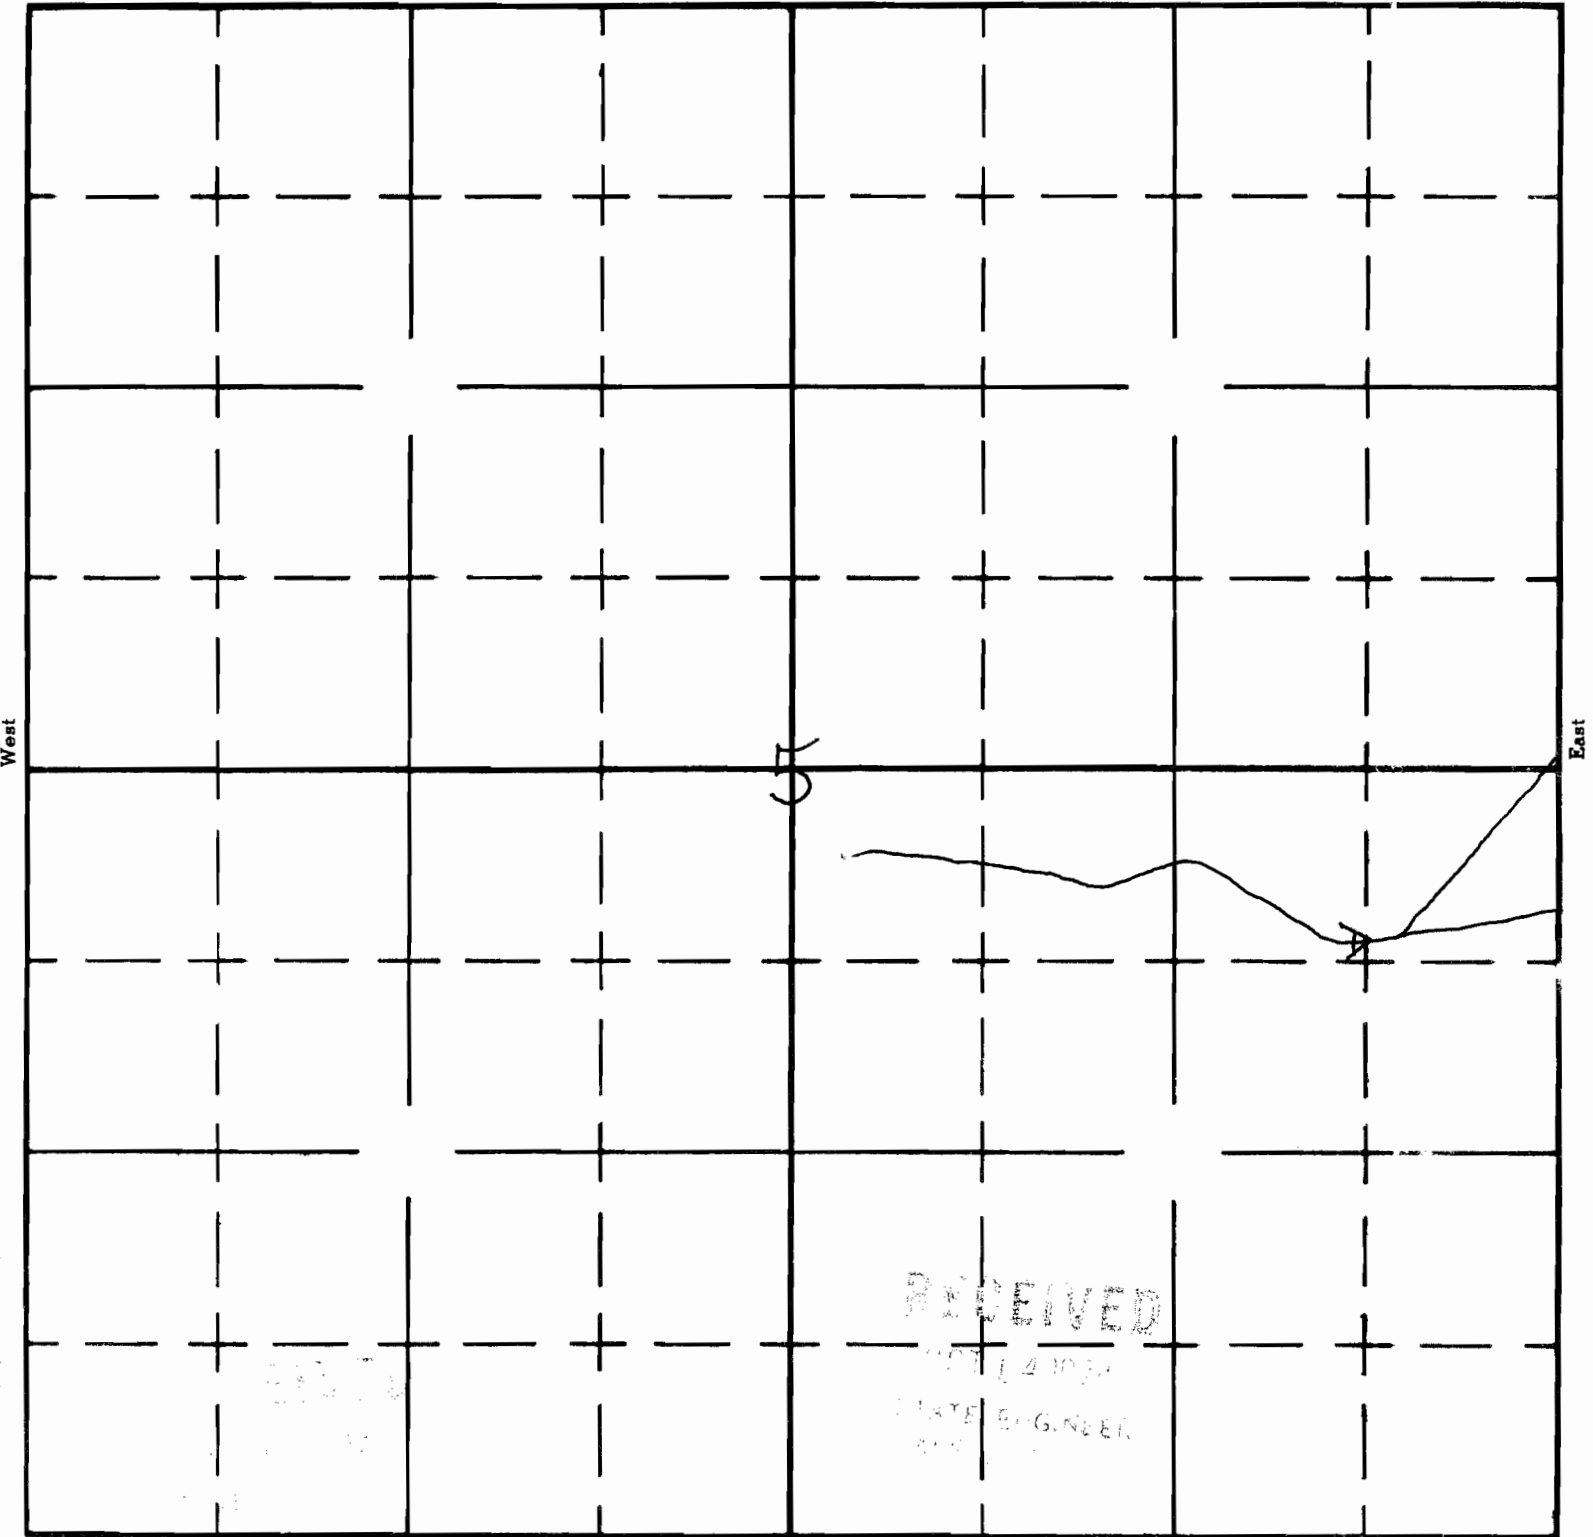

South

APPLICATION No. R-52290

PERMIT No. R 7915