

UNITED STATES
DEPARTMENT OF THE INTERIOR
BUREAU OF LAND MANAGEMENT

SECTION

8

Oregon State Water Filings


NW SE

TOWNSHIP 31S, RANGE 31E, W. M.

Scale 4" = 1 mile

North

Oscar Res

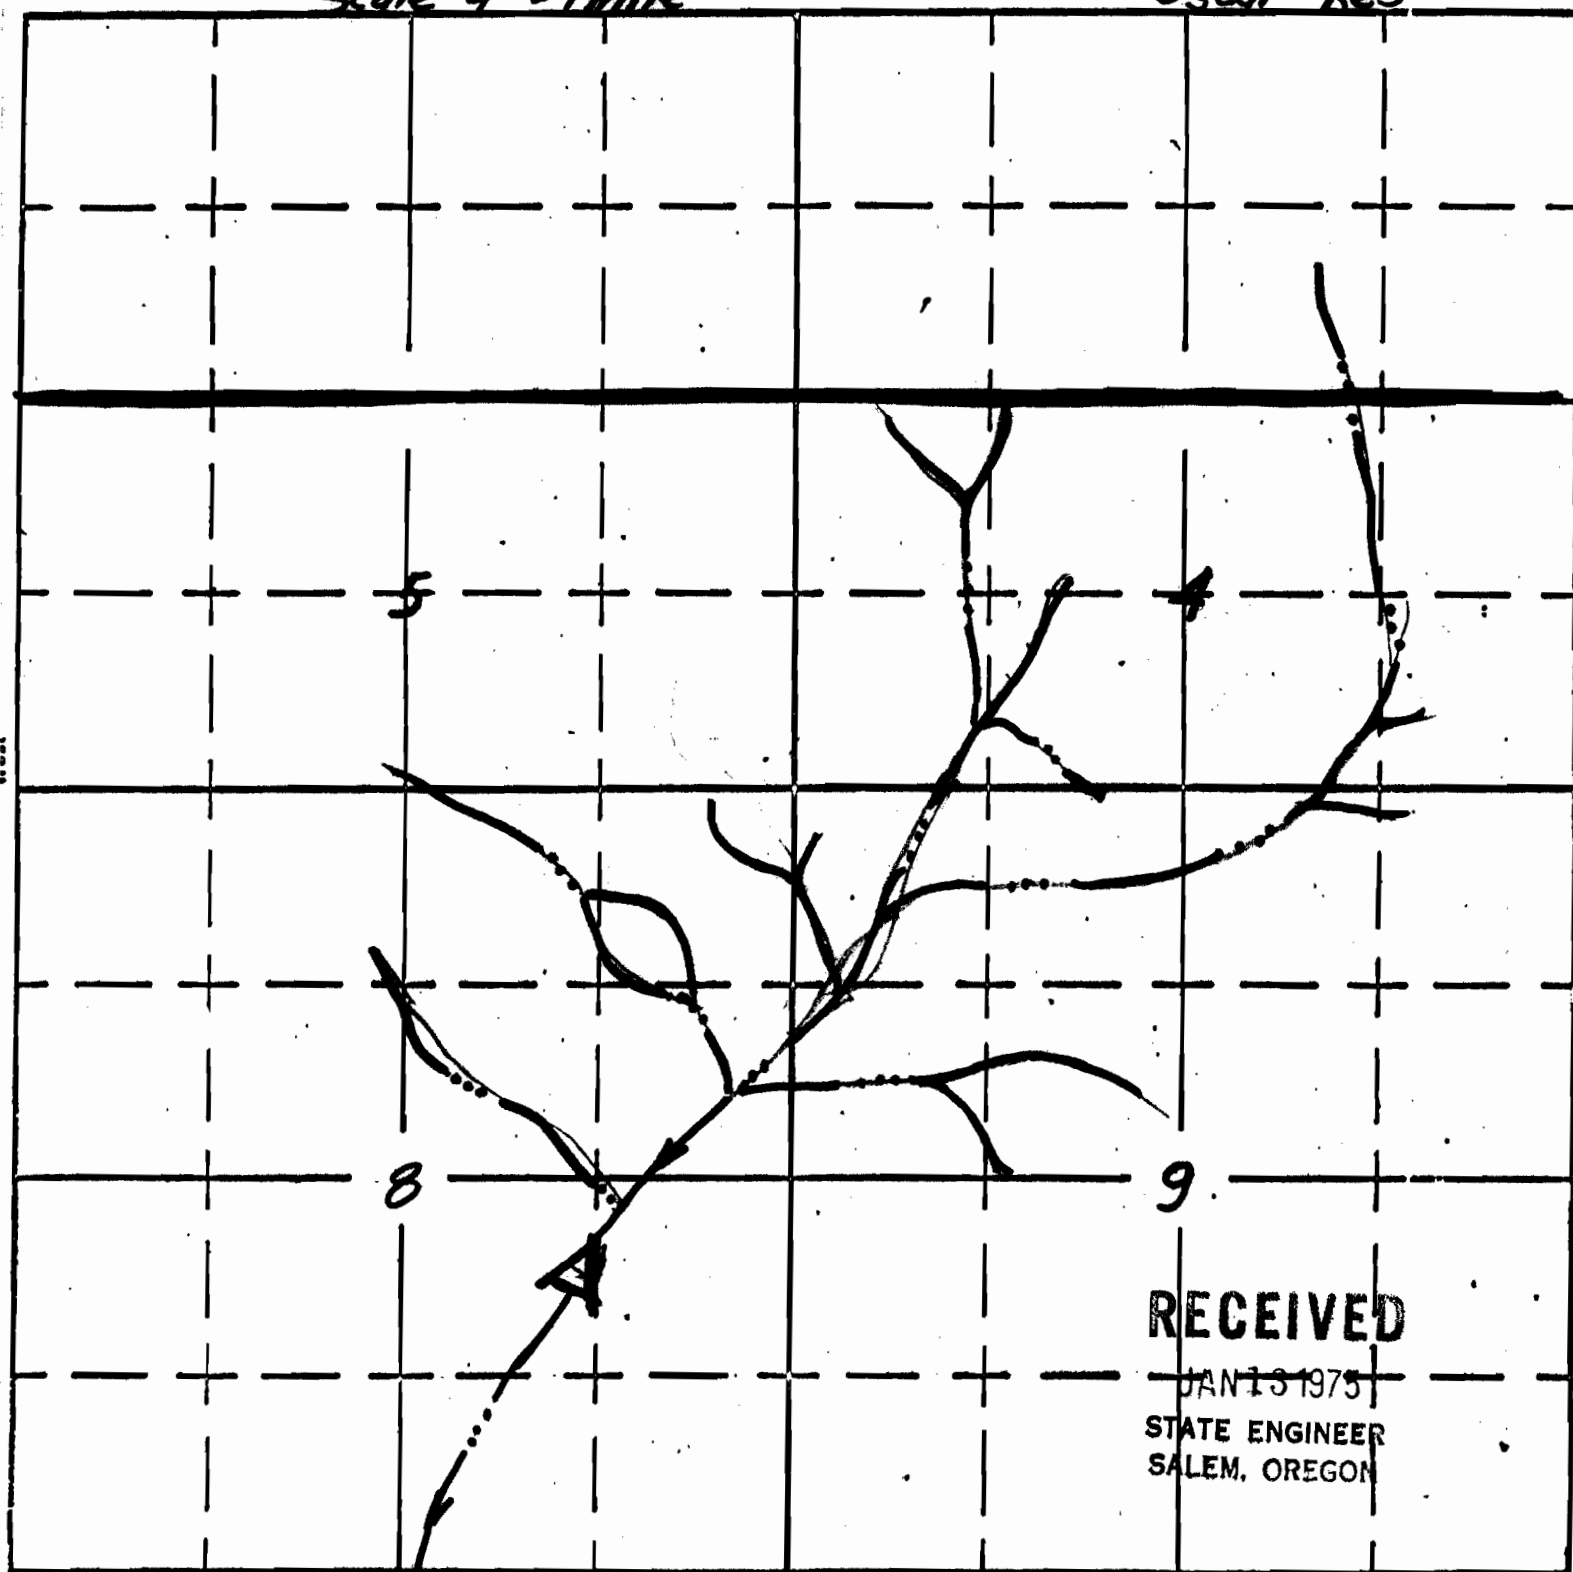

South

RECEIVED

JAN 13 1975
STATE ENGINEER
SALEM, OREGON

APPLICATION No.
PERMIT No.

Application No. R-52701
Permit No. R 7660