

March 1961

UNITED STATES
DEPARTMENT OF THE INTERIOR
BUREAU OF LAND MANAGEMENT


Getty Spring 107 5000

SECTION
19
SE 1/4 NE 1/4

Oregon State Water Filings

TOWNSHIP 32 S., RANGE 36 E., W. M.

North

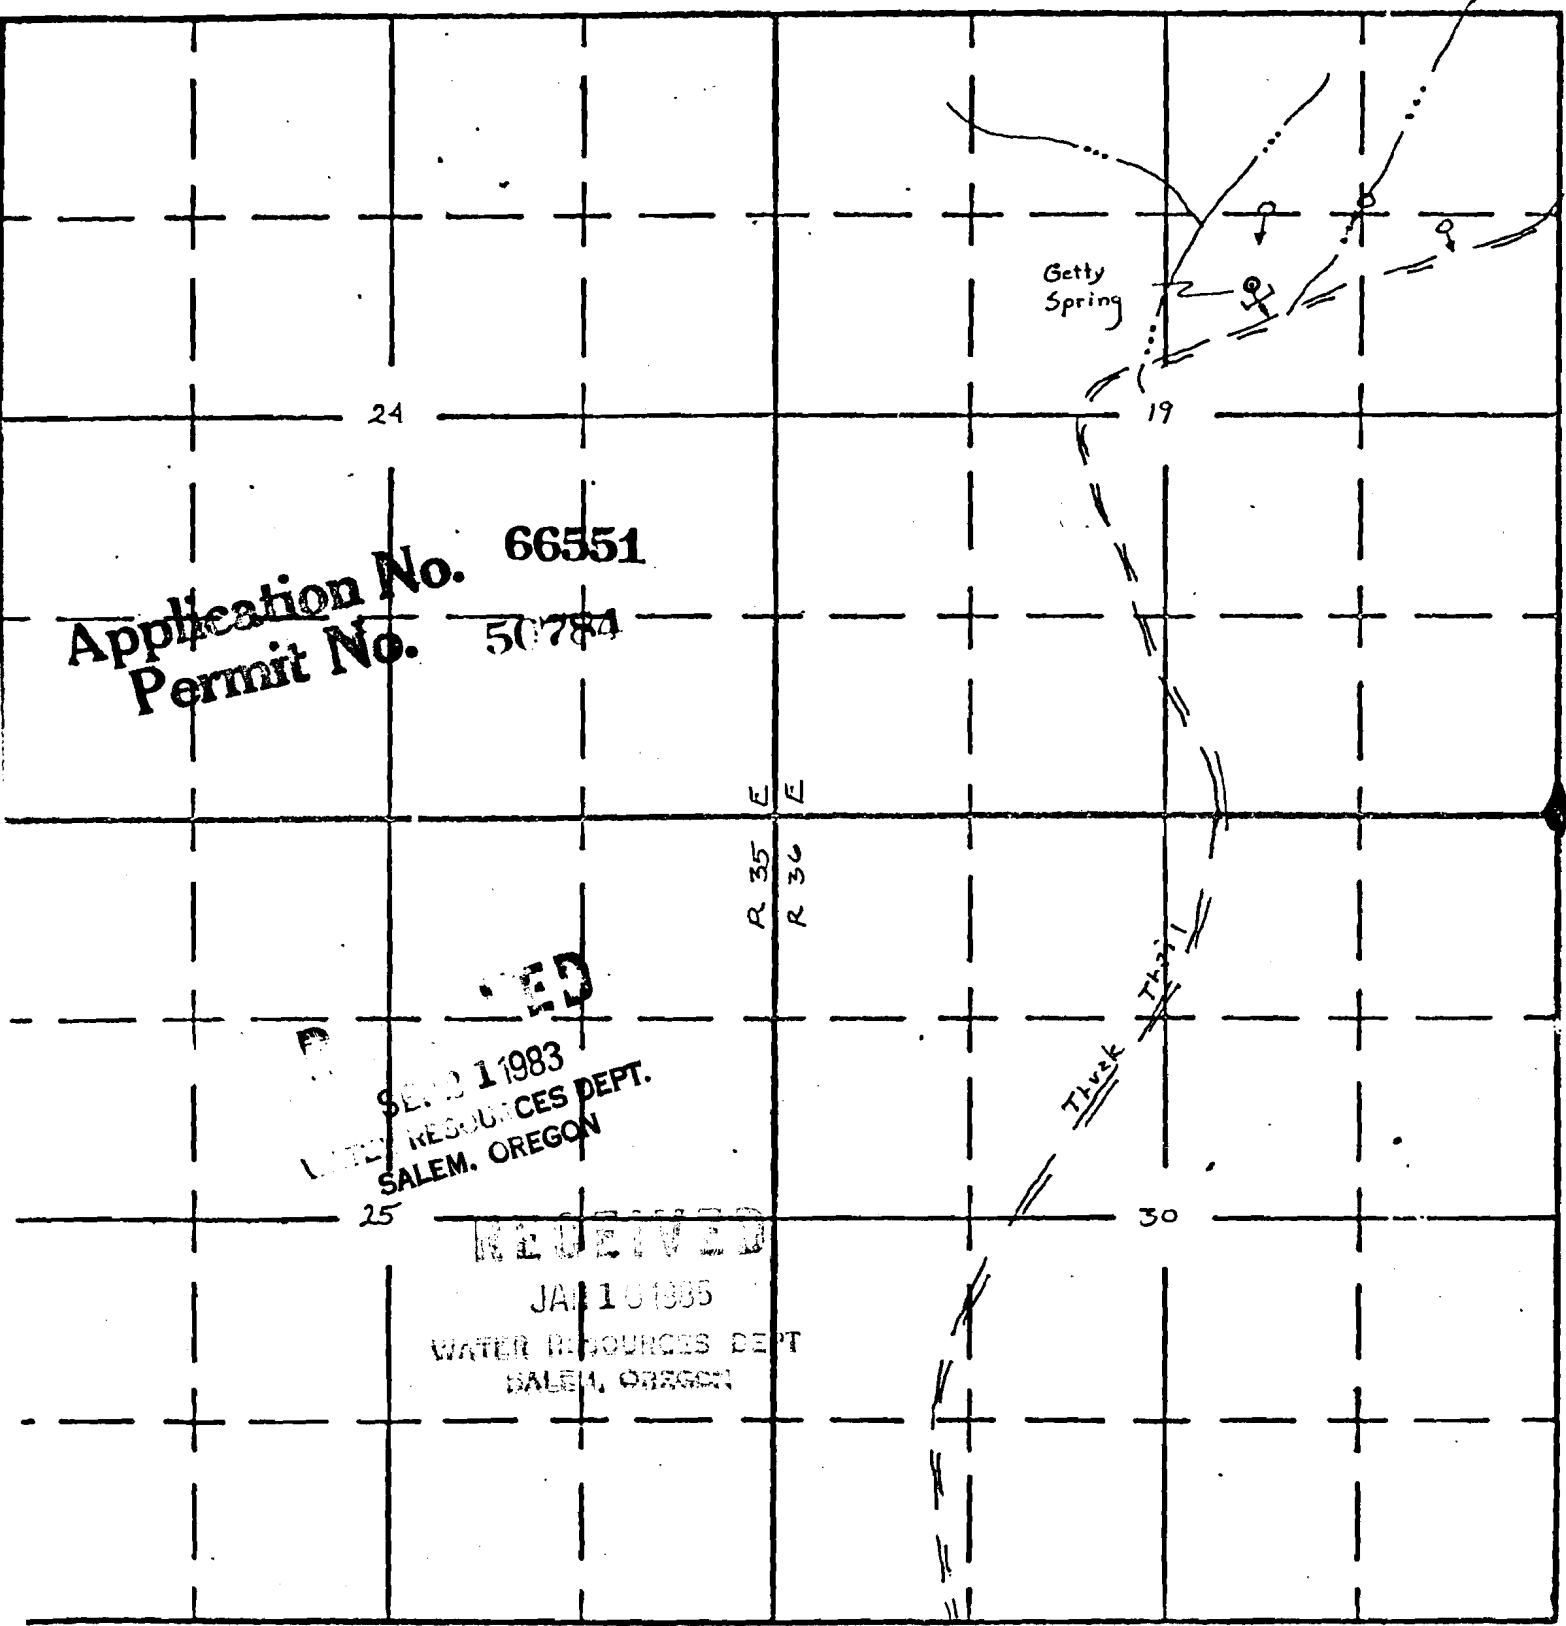

Application No. 66551
Permit No. 50784

RECEIVED
SEP 2 1983
WATER RESOURCES DEPT.
SALEM, OREGON

RECEIVED
JAN 10 1985
WATER RESOURCES DEPT
SALEM, OREGON

R 35 E
R 36 E

South

APPLICATION No.