

AUL 19 1981

FIELD MAP SHEET

WATER RESOURCES DEPT
SALEM, OREGON

T. 40S/41S R. 17E/18E Sec. _____ Subdiv. _____ N.F. _____


Mapped by _____ Reviewed by _____ Scale 2 inches = 1 Mile

- RESERVOIR
- DRAINAGE
- ROAD

Application No. R-62521

Permit No. R 9119

19

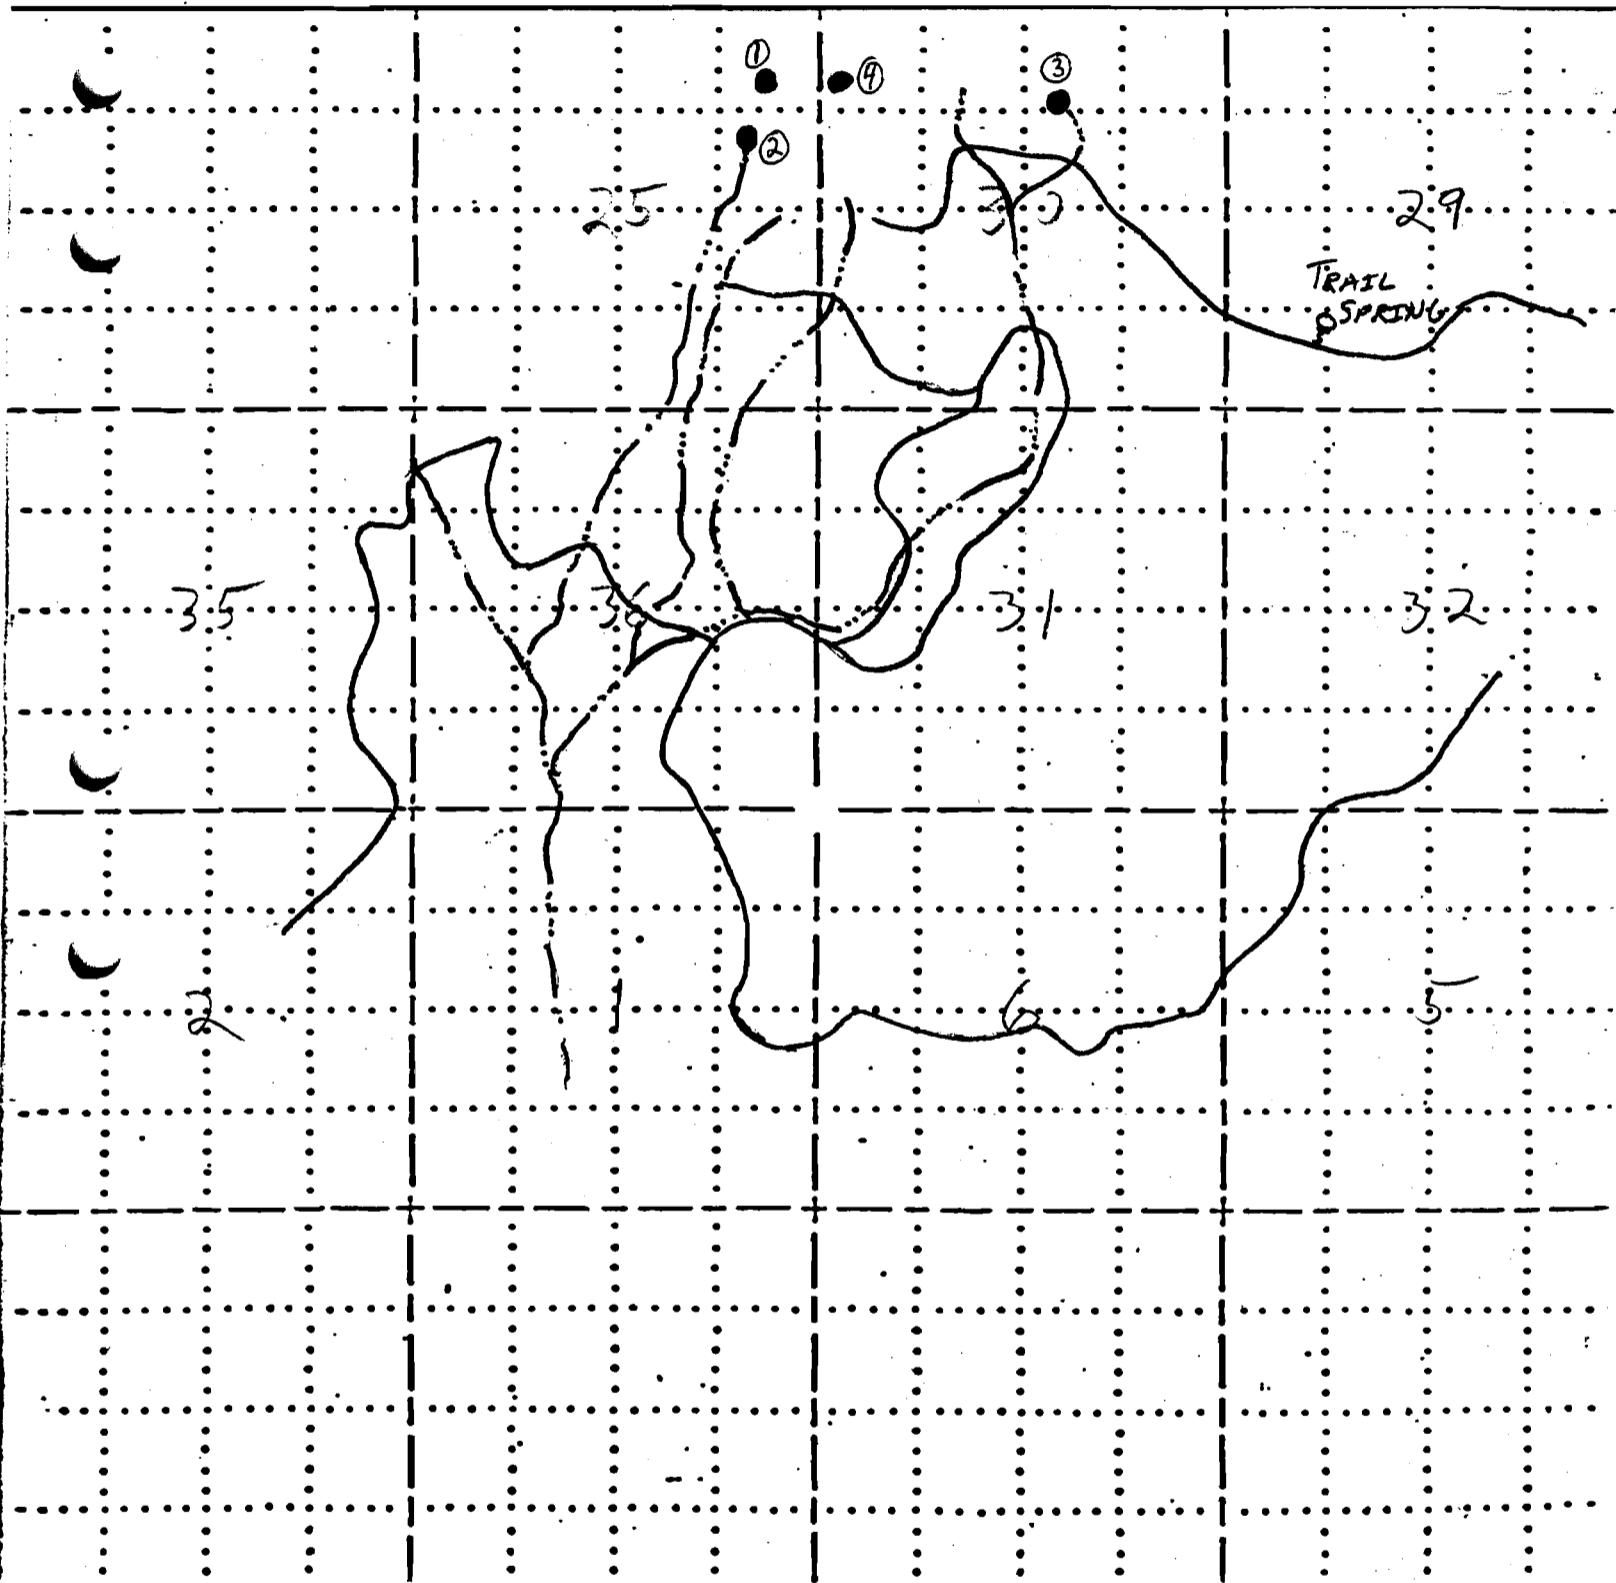

RECEIVED

AUG 19 1981

WATER RESOURCES DEPT
SALEM, OREGON

40 N 25, 30

Application No. R-62521
Permit No. R 9119

