

FIELD MAP SHEET

AUG 19 1981


WATER RESOURCES DEPT.
SALEM, OREGON N.F.

T. 40S R. 17E Sec. Subdiv.

Mapped by Reviewed by Scale 2 inches = 1 Mile

- RESERVOIR
- DRAINAGE
- ROAD

Application No. R-62522, 19
Permit No. R 9120

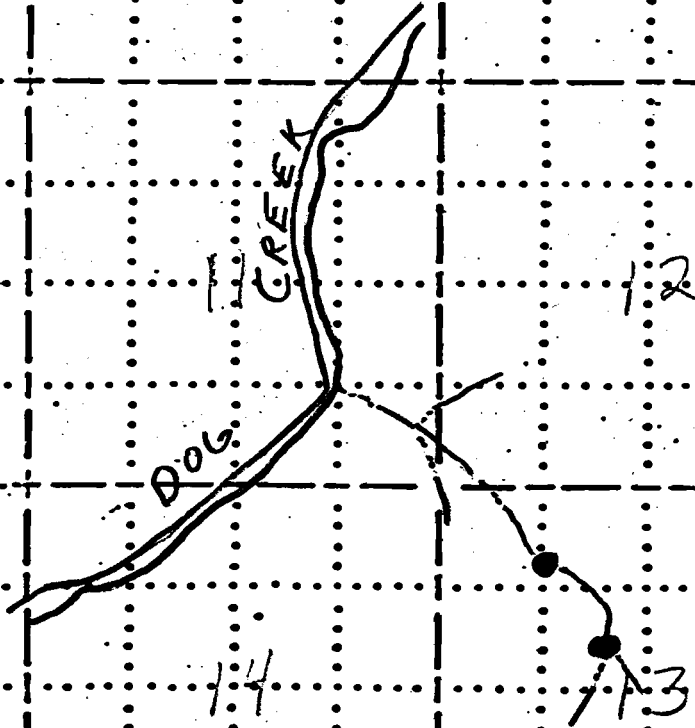

RECEIVED

AUG 19 1981

WATER RESOURCES DEPT
SALEM, OREGON 6

Application No. R-62522
Permit No. R 9120

