


RECEIVED R 9121
66322

AUG 19 1981

WATER RESOURCES DEPT
SALEM, OREGON

Application No. R-62523
Permit No. R 9121

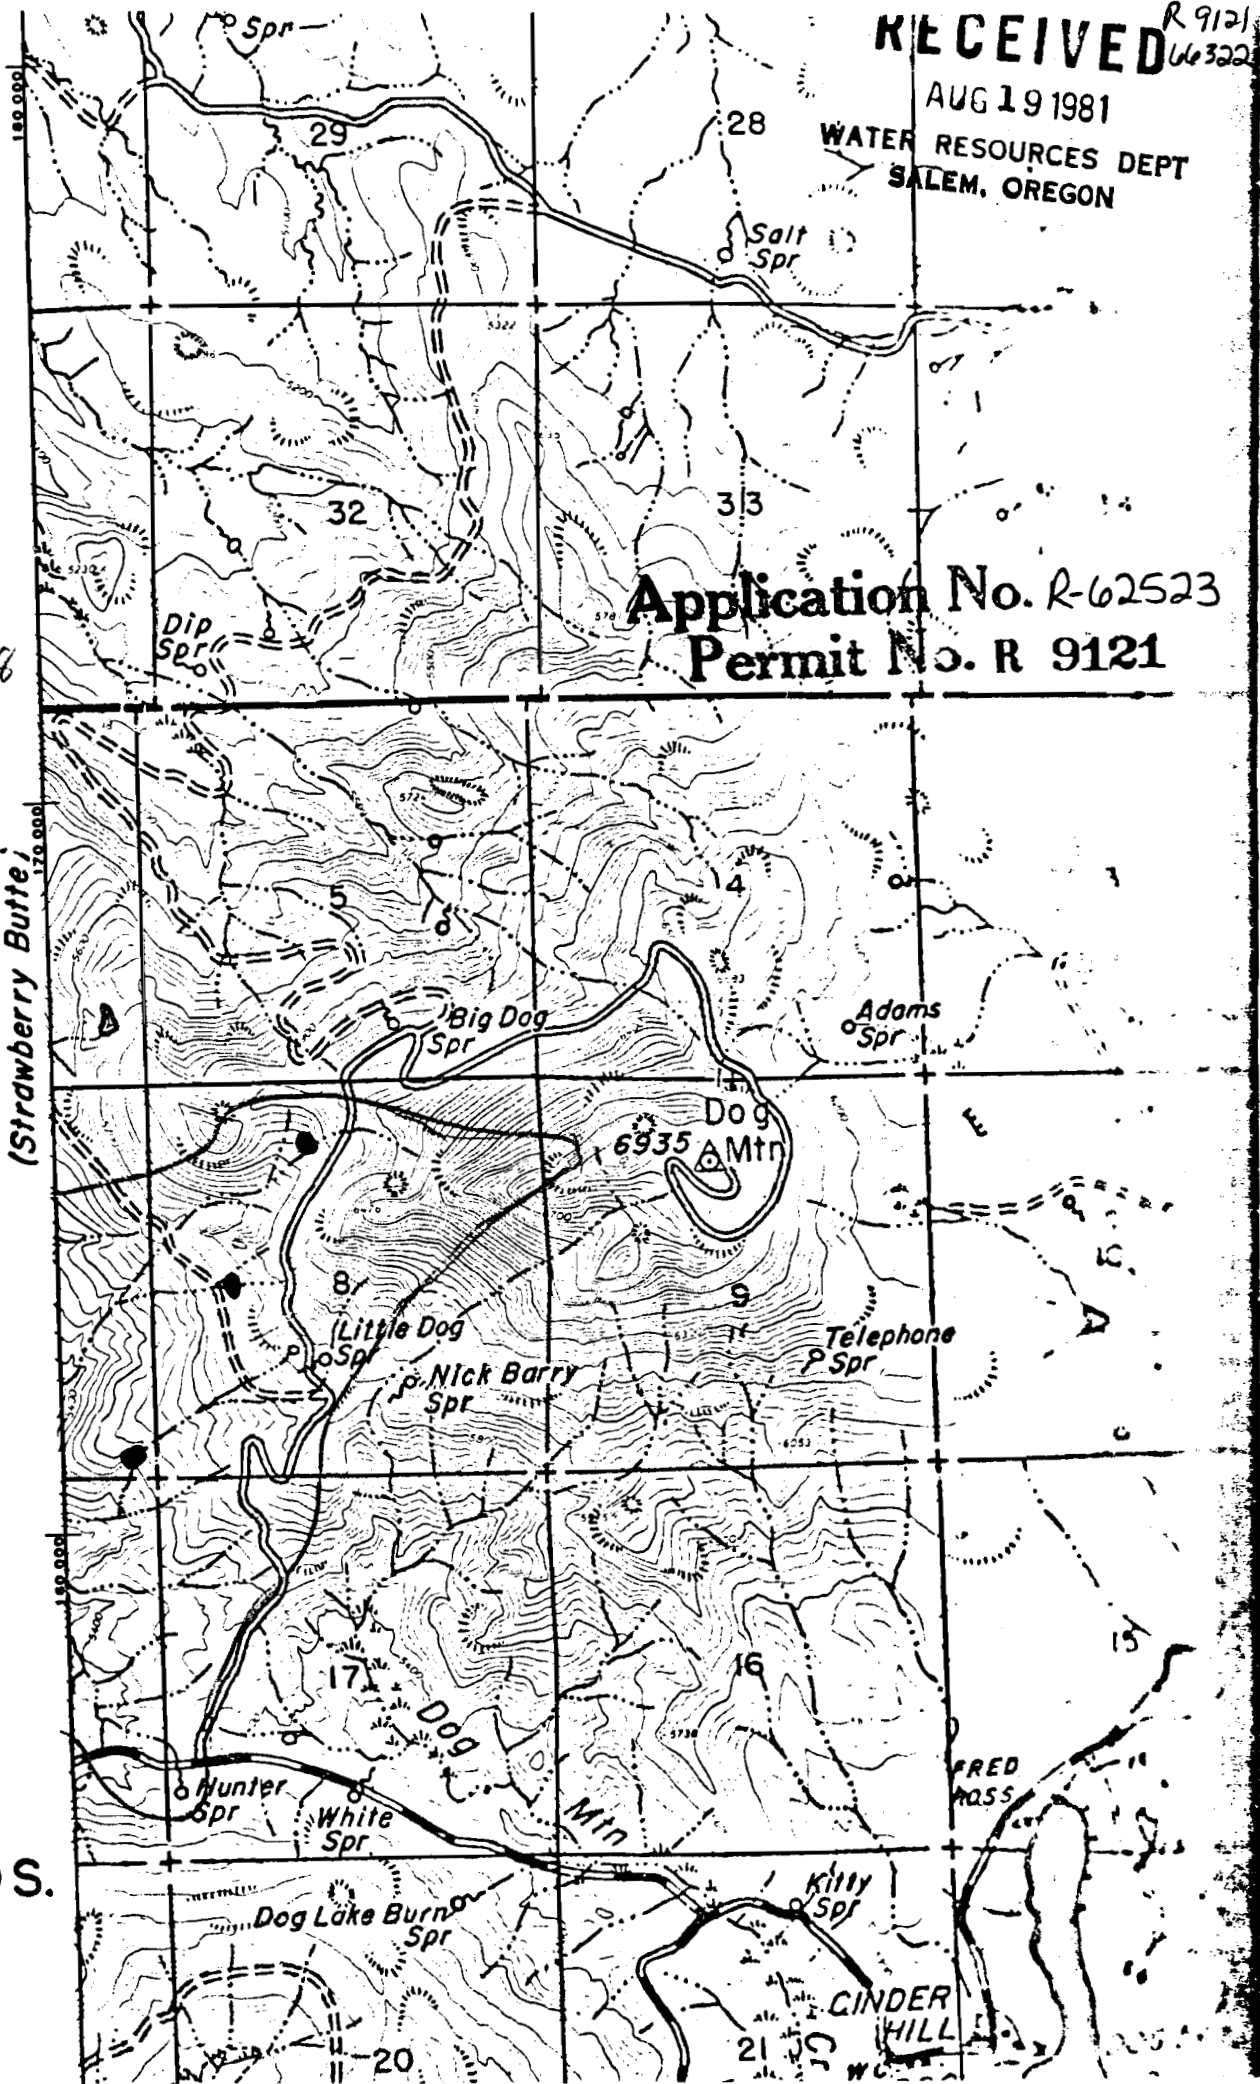

40 17 78

(464)

(Strawberry Butte)

T.40S.

RECEIVED

AUG 19 1981 66322

WATER RESOURCES DEPT
SALEM, OREGON

40 17 7,8

Application No. R-62523
Permit No. R 9121

(465)

(Vistillas 4)

T.40S.

05'

