

AUG 19 1981

FIELD MAP SHEET WATER RESOURCES DEPT
SALEM, OREGON

T. ⁴⁰⁵/₄₁₅ R. 17E Sec. Subdiv. N.F.


Mapped by Reviewed by Scale 2 inches = 1 Mile

- RESERVIOR
- DRAINAGE
- ROAD

Application No. R-62524

Permit No. R 9122

19

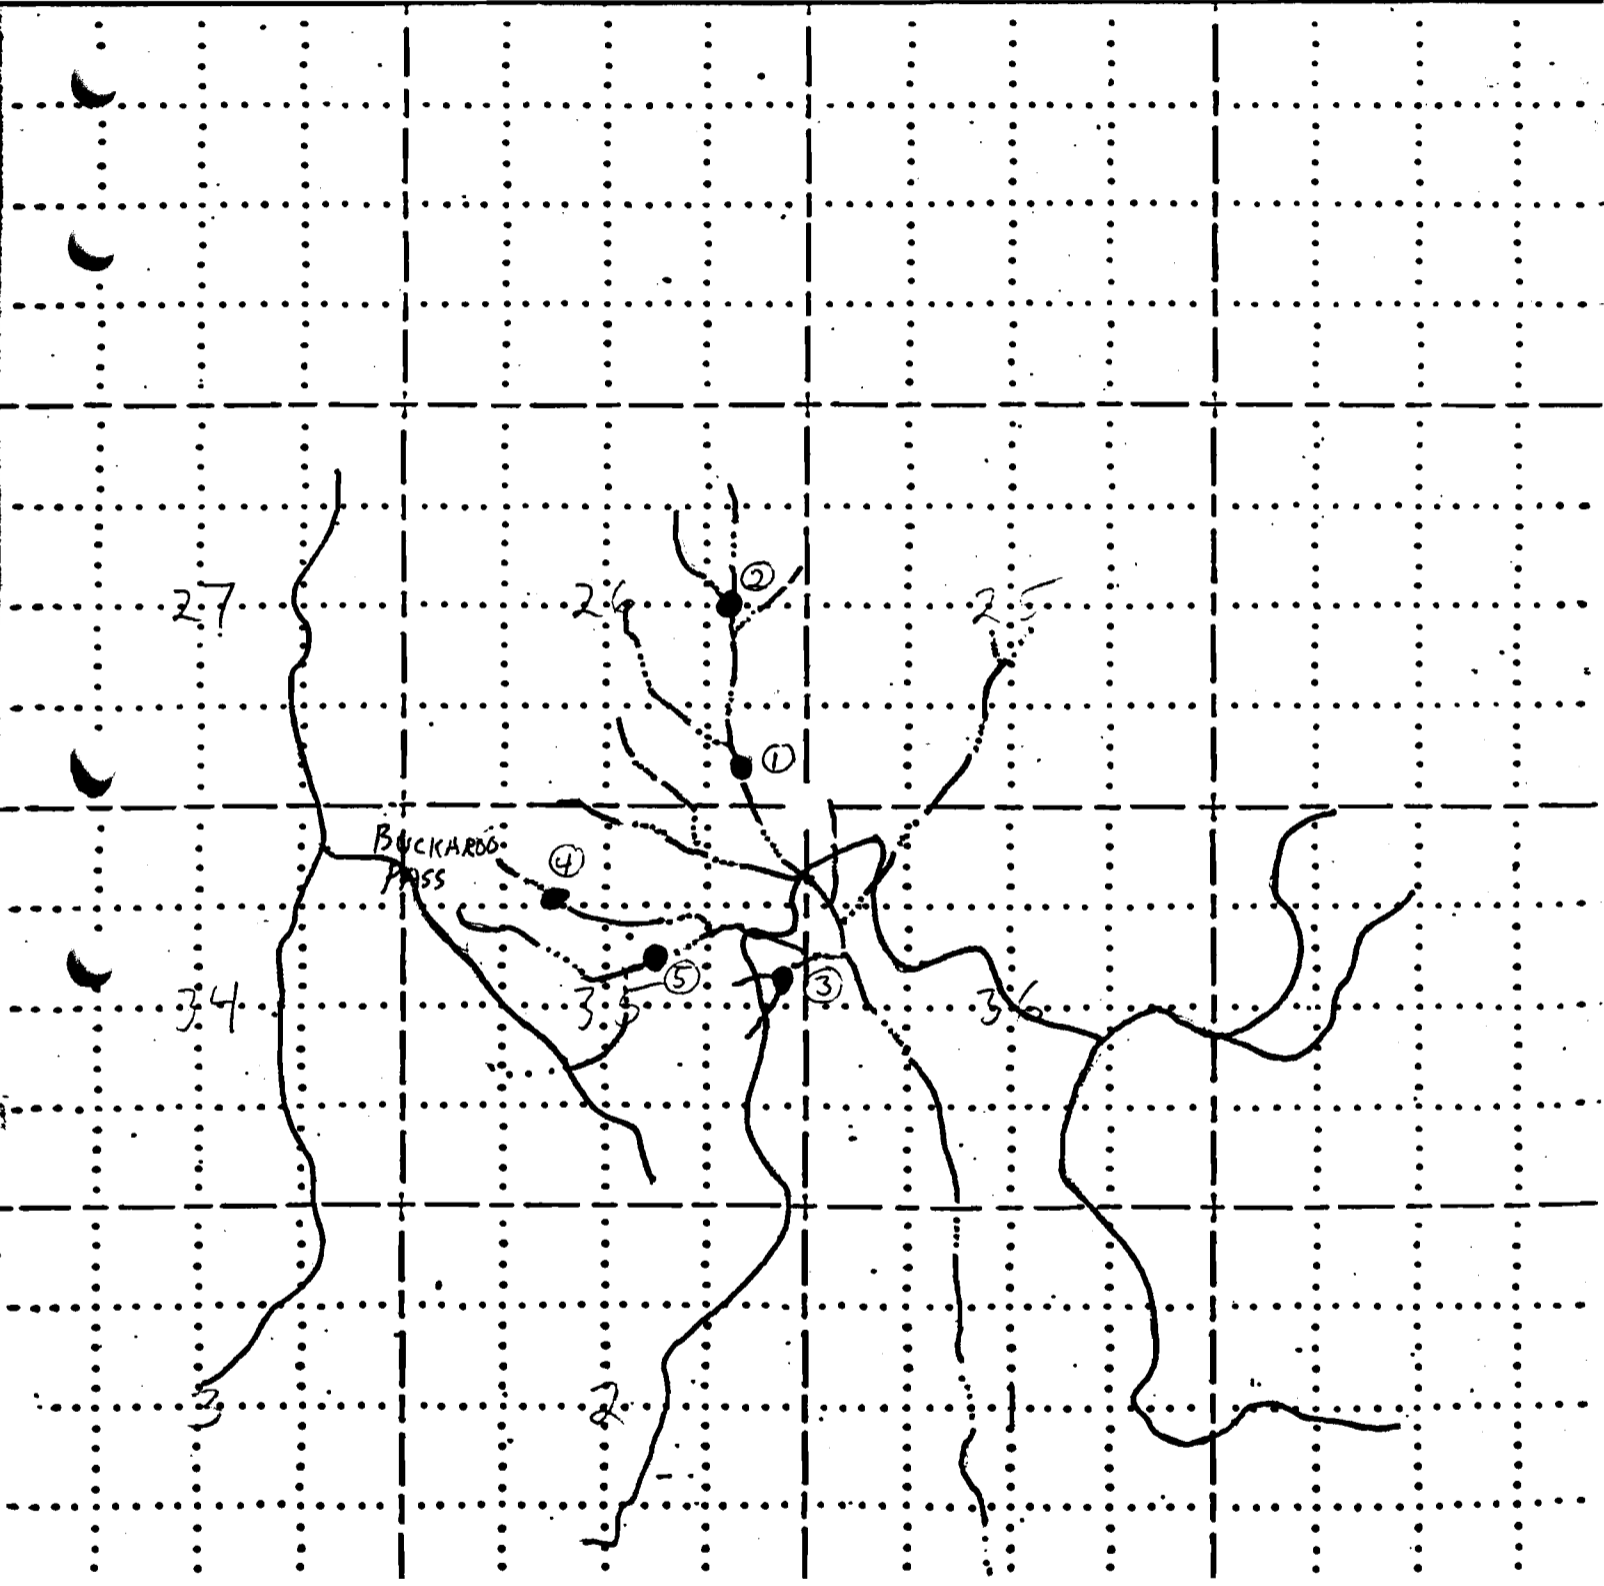

RECEIVED.

AUG 19 1981

WATER RESOURCES DEPT
SALEM, OREGON

40 17 26 35

Application No. R-62524
Permit No. R 9122

