

Application No. R-62805
FIELD MAP SHEET

Permit No. R 9717

T. 355 / 365 R. 18E Sec. _____ Subdiv. _____ FREMONT N.F.

Mapped by T. OLENICHAK Reviewed by _____ Scale 2 inches = 1 Mile


- RESERVOIR
- DRAINAGE
- ROAD

RECEIVED

8/18, 19 81

SEP 17 1981

WATER RESOURCES DEPT
SALEM, OREGON

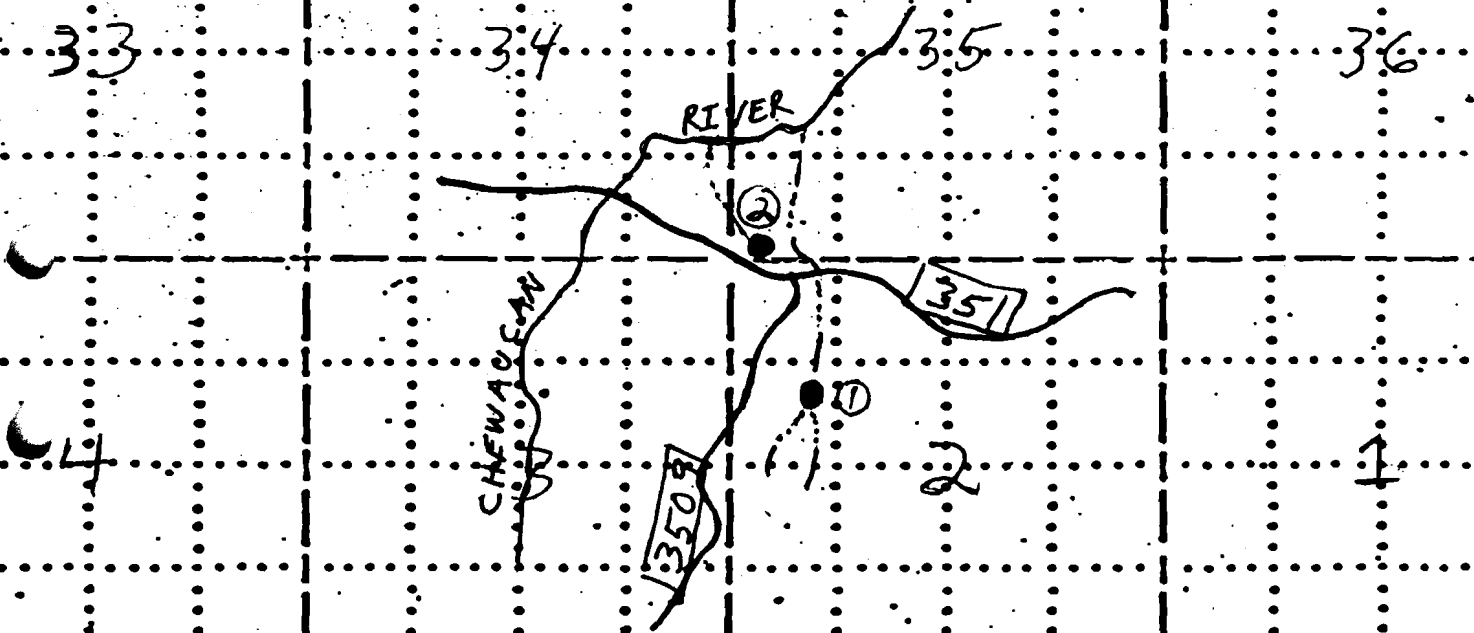

RECEIVED

SEP 17 1983

WATER RESOURCES DEPT.
SALEM, OREGON

RECEIVED

SEP 17 1981

VISTILLAS 10


OREG

WATER RESOURCES DEPT
SALEM, OREGON

Application No. R-62805

Permit No. R 9717

R.18E.35'

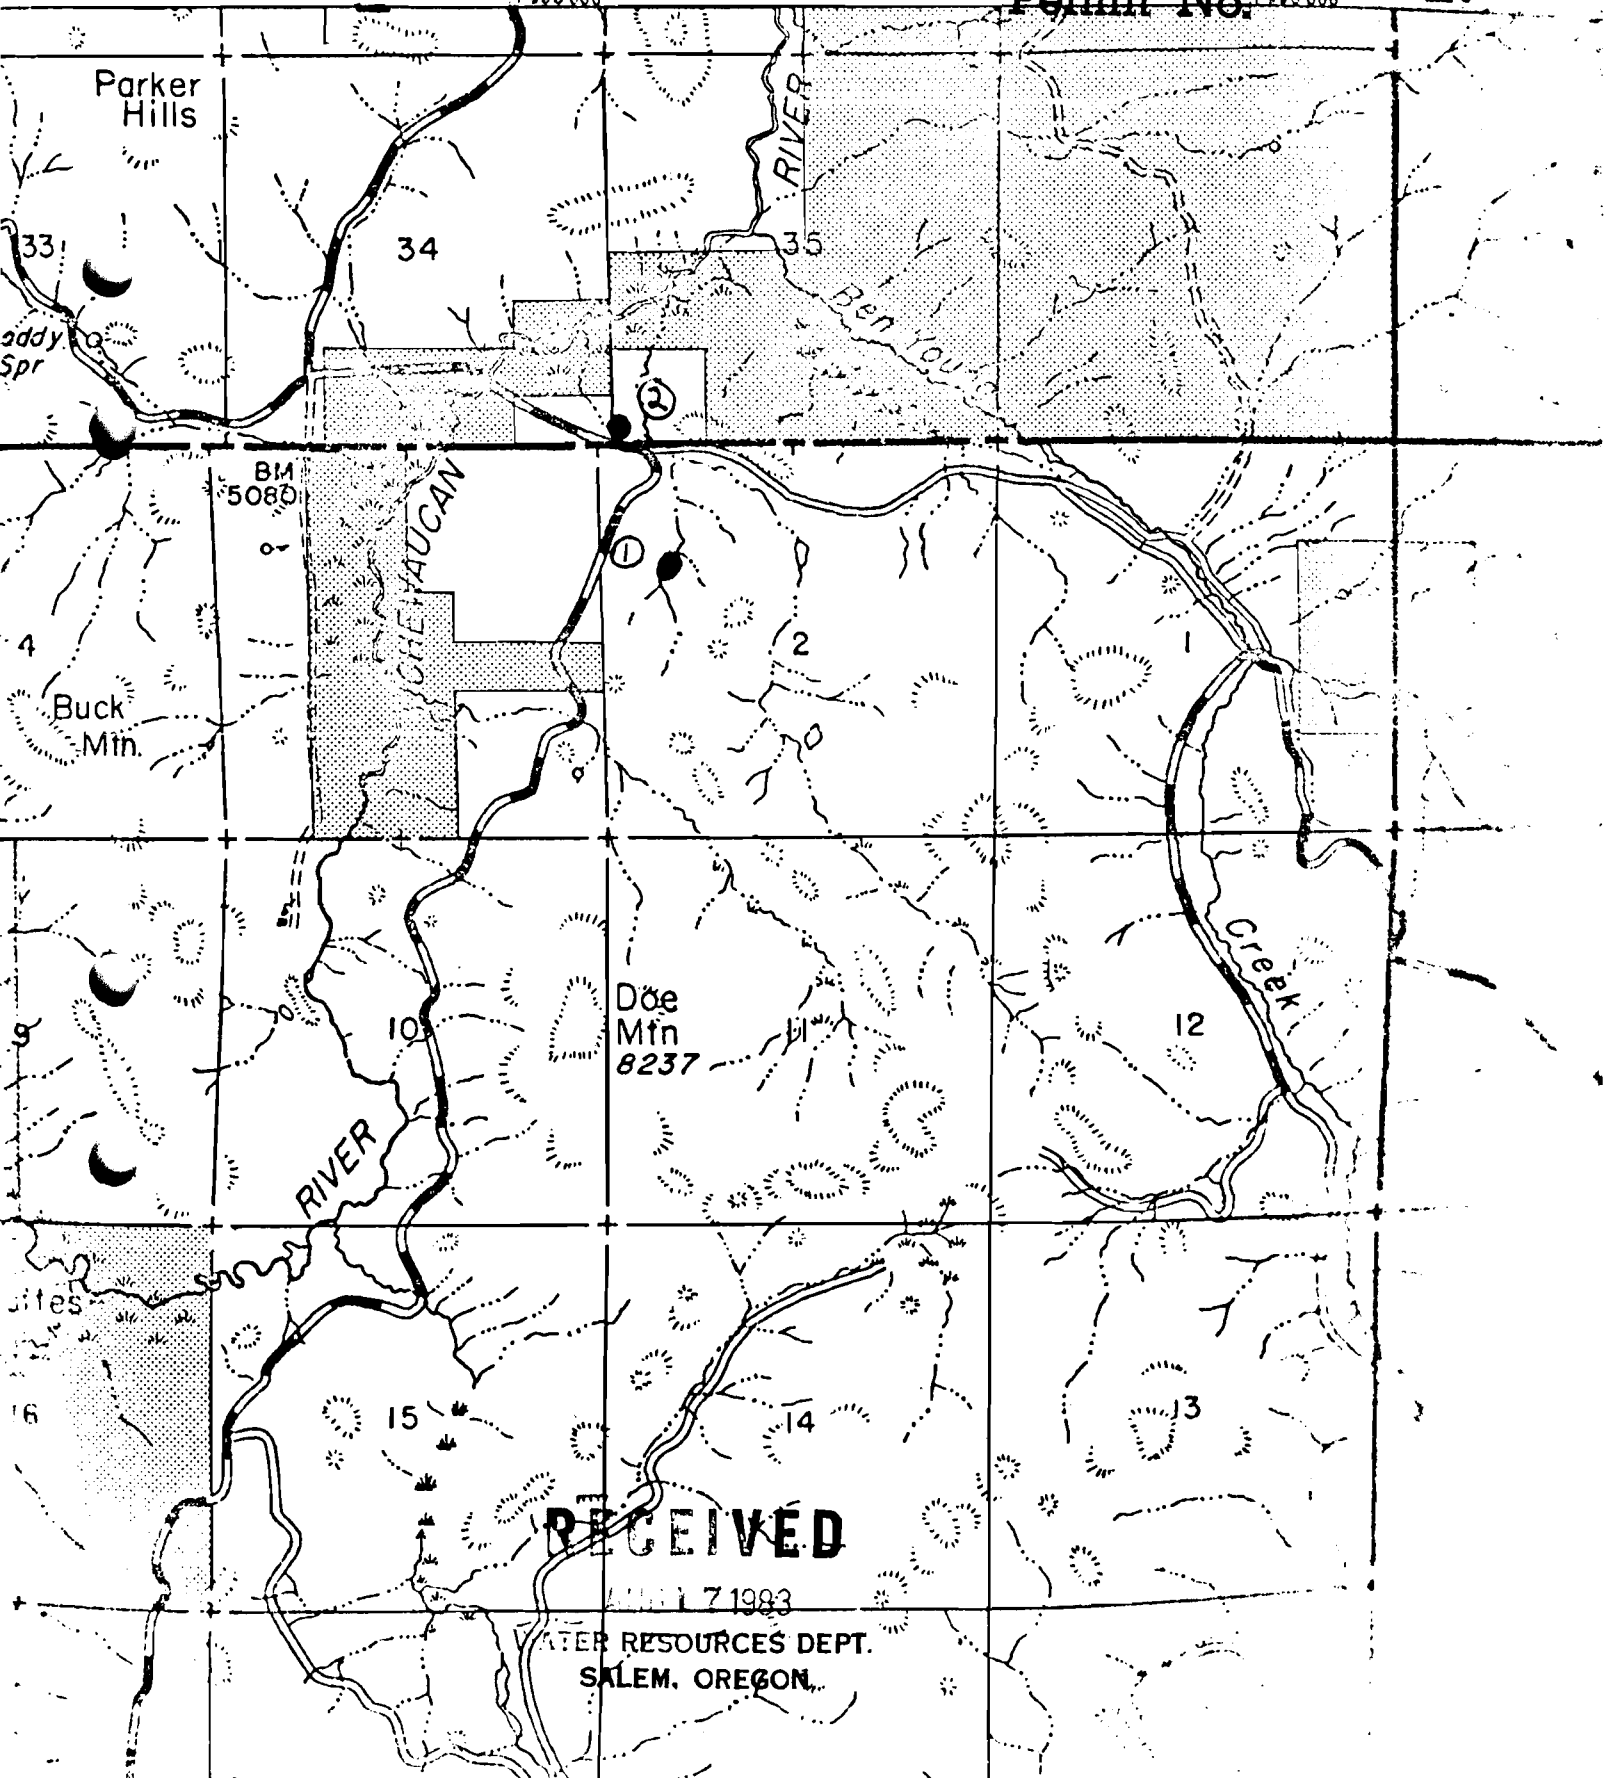

RECEIVED

APR 7 1983

WATER RESOURCES DEPT.
SALEM, OREGON.