

Revised July 1941

FOREST SERVICE

FIELD MAP SHEET

Application No. R-62806

Permit No. R 9718

T. ³⁴⁵~~355~~ R. ^{17E}~~18E~~ Sec. _____ Subdiv. _____ FREMONT N.F.

Mapped by J. OLENICHAK Reviewed by _____ Scale 2 inches = 1 Mile

● RESERVOIR


--- DRAINAGE

— ROAD

RECEIVED

SEP 17 1981

WATER RESOURCES DEPT
SALEM, OREGON

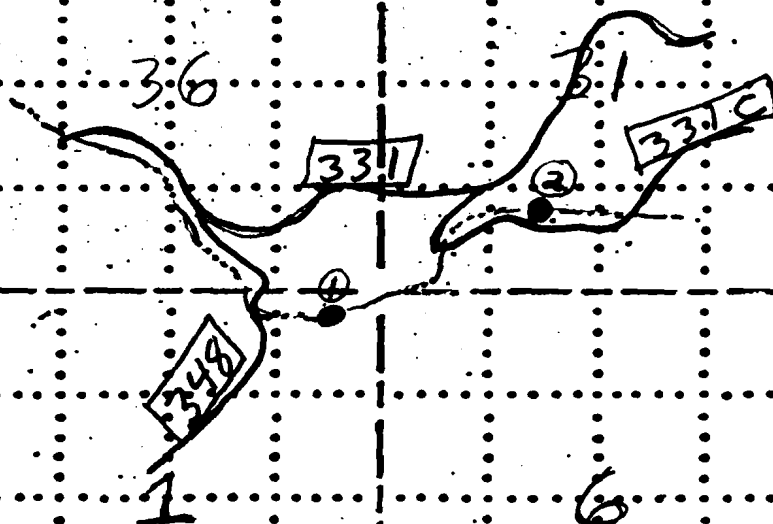


RECEIVED

AUG 17 1983

WATER RESOURCES DEPT
SALEM, OREGON

24 17 1
35 17 31

Application No. R-62806
Permit No. R 9718

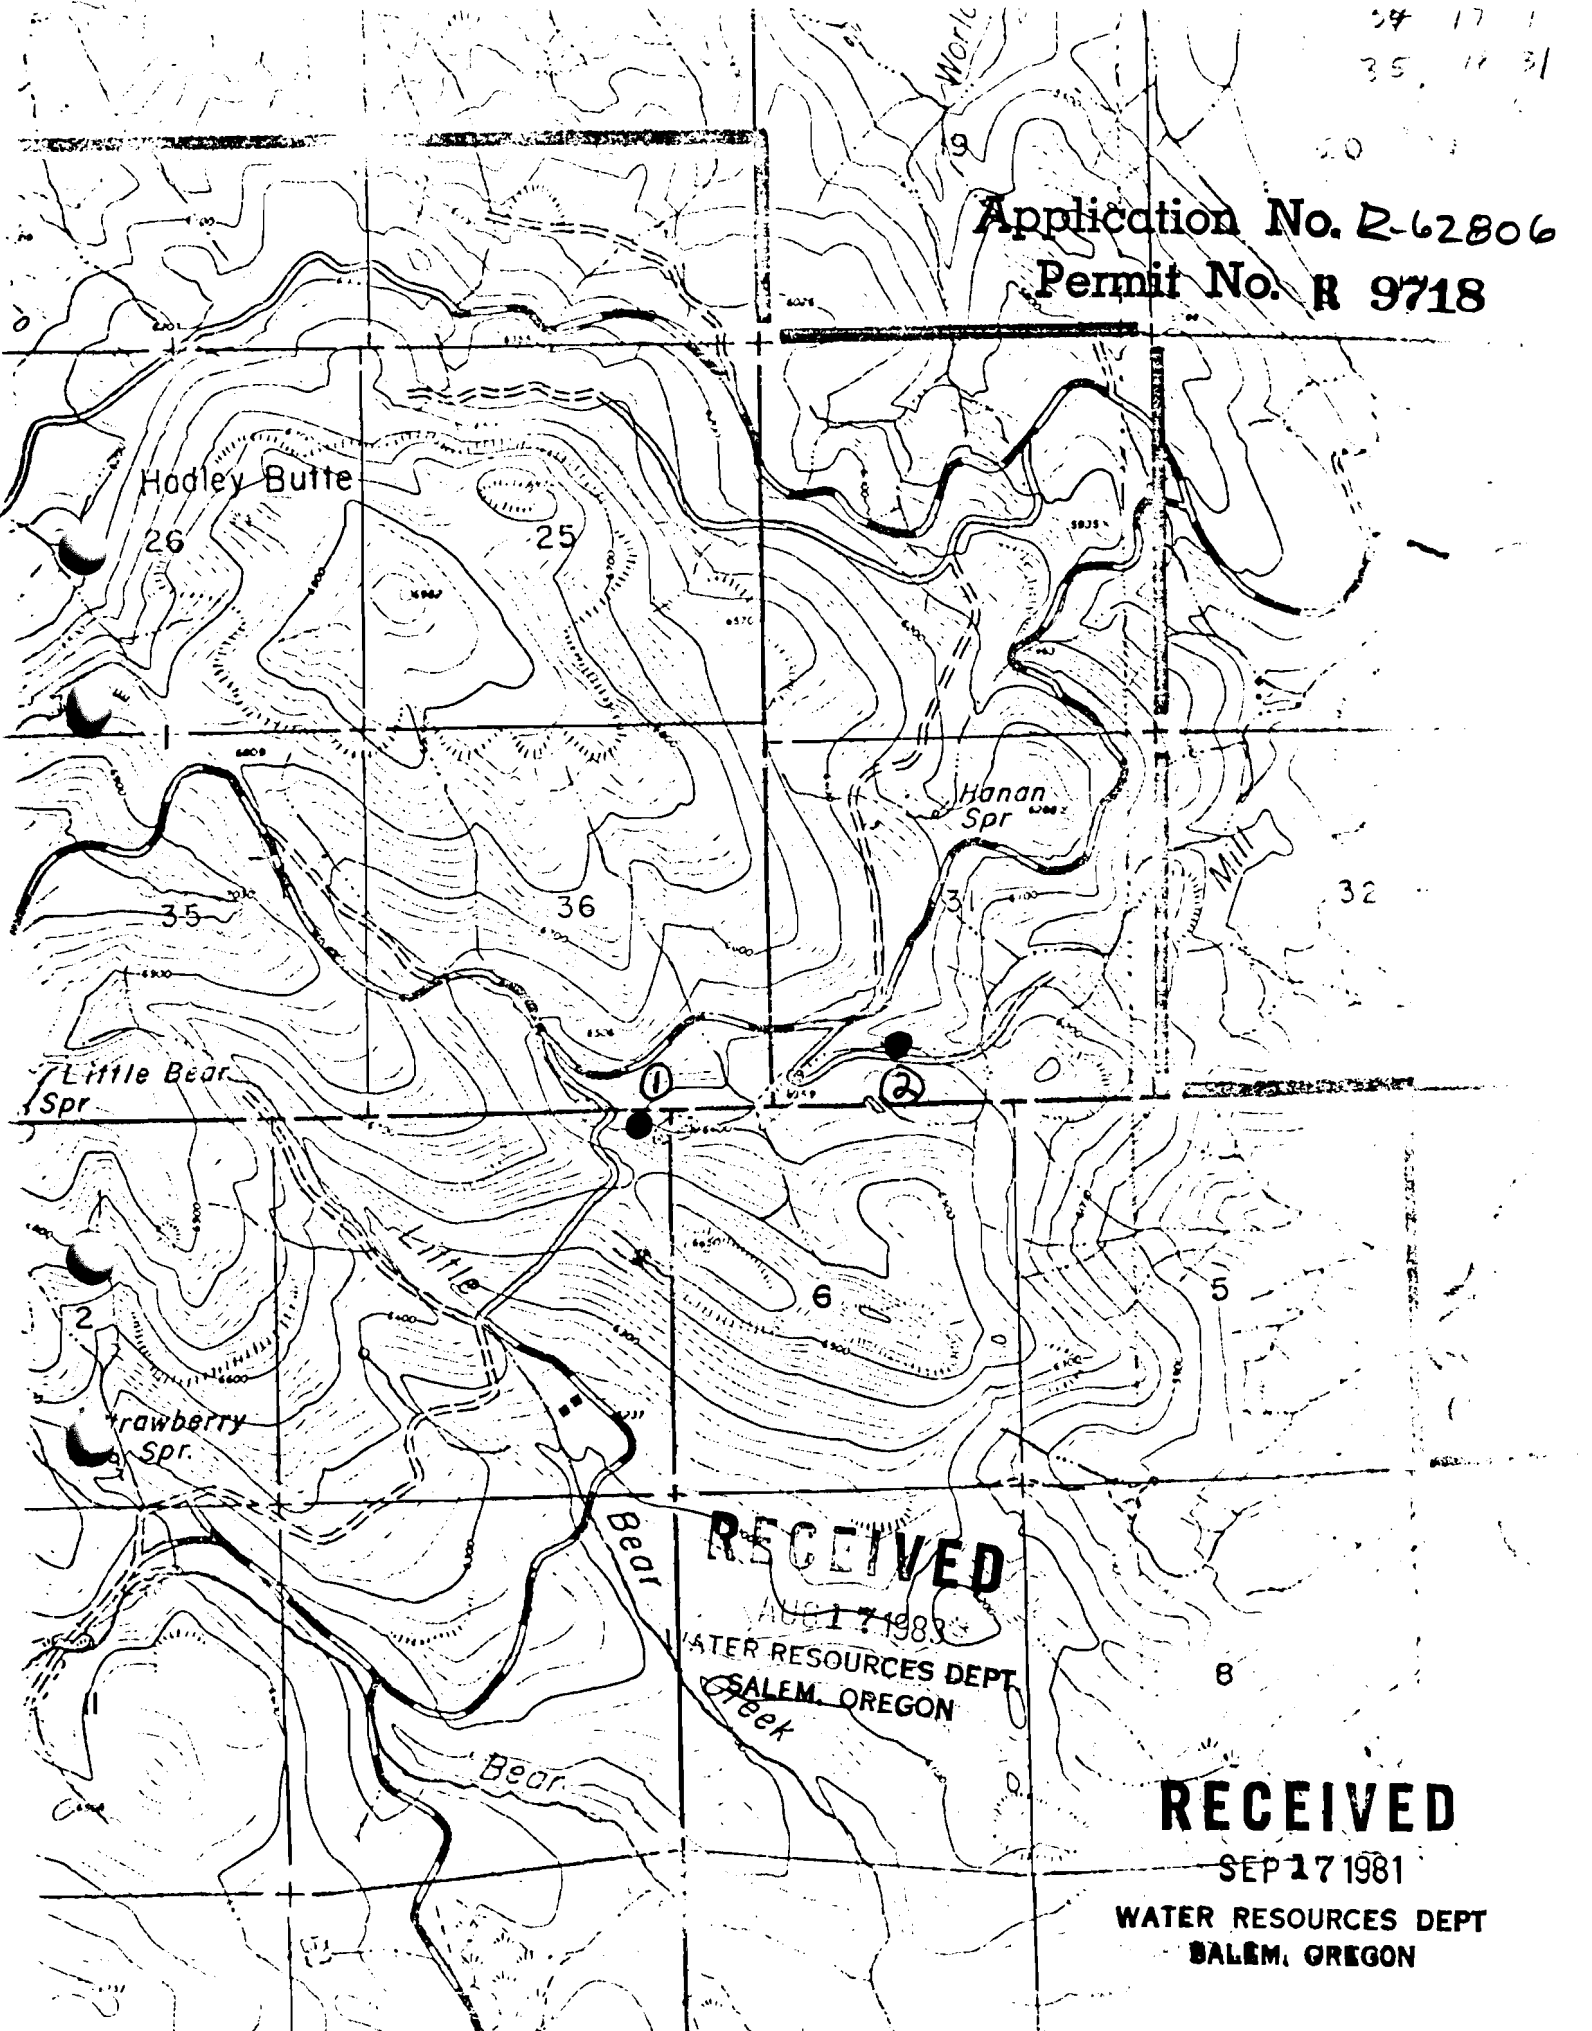

RECEIVED


WATER RESOURCES DEPT
SALEM, OREGON

RECEIVED

SEP 17 1981

WATER RESOURCES DEPT
SALEM, OREGON