

FIELD MAP SHEET

Permit No. R 9719

T. ~~15E~~ R. 15E/16E Sec. Subdiv. FREMONT N.F.

Mapped by T. OLENICHAK Reviewed by _____ Scale 2 inches = 1 Mile


● RESERVOIR
--- DRAINAGE
— ROAD

RECEIVED

8/18, 1981

SEP 17 1981

WATER RESOURCES DEPT
SALEM, OREGON

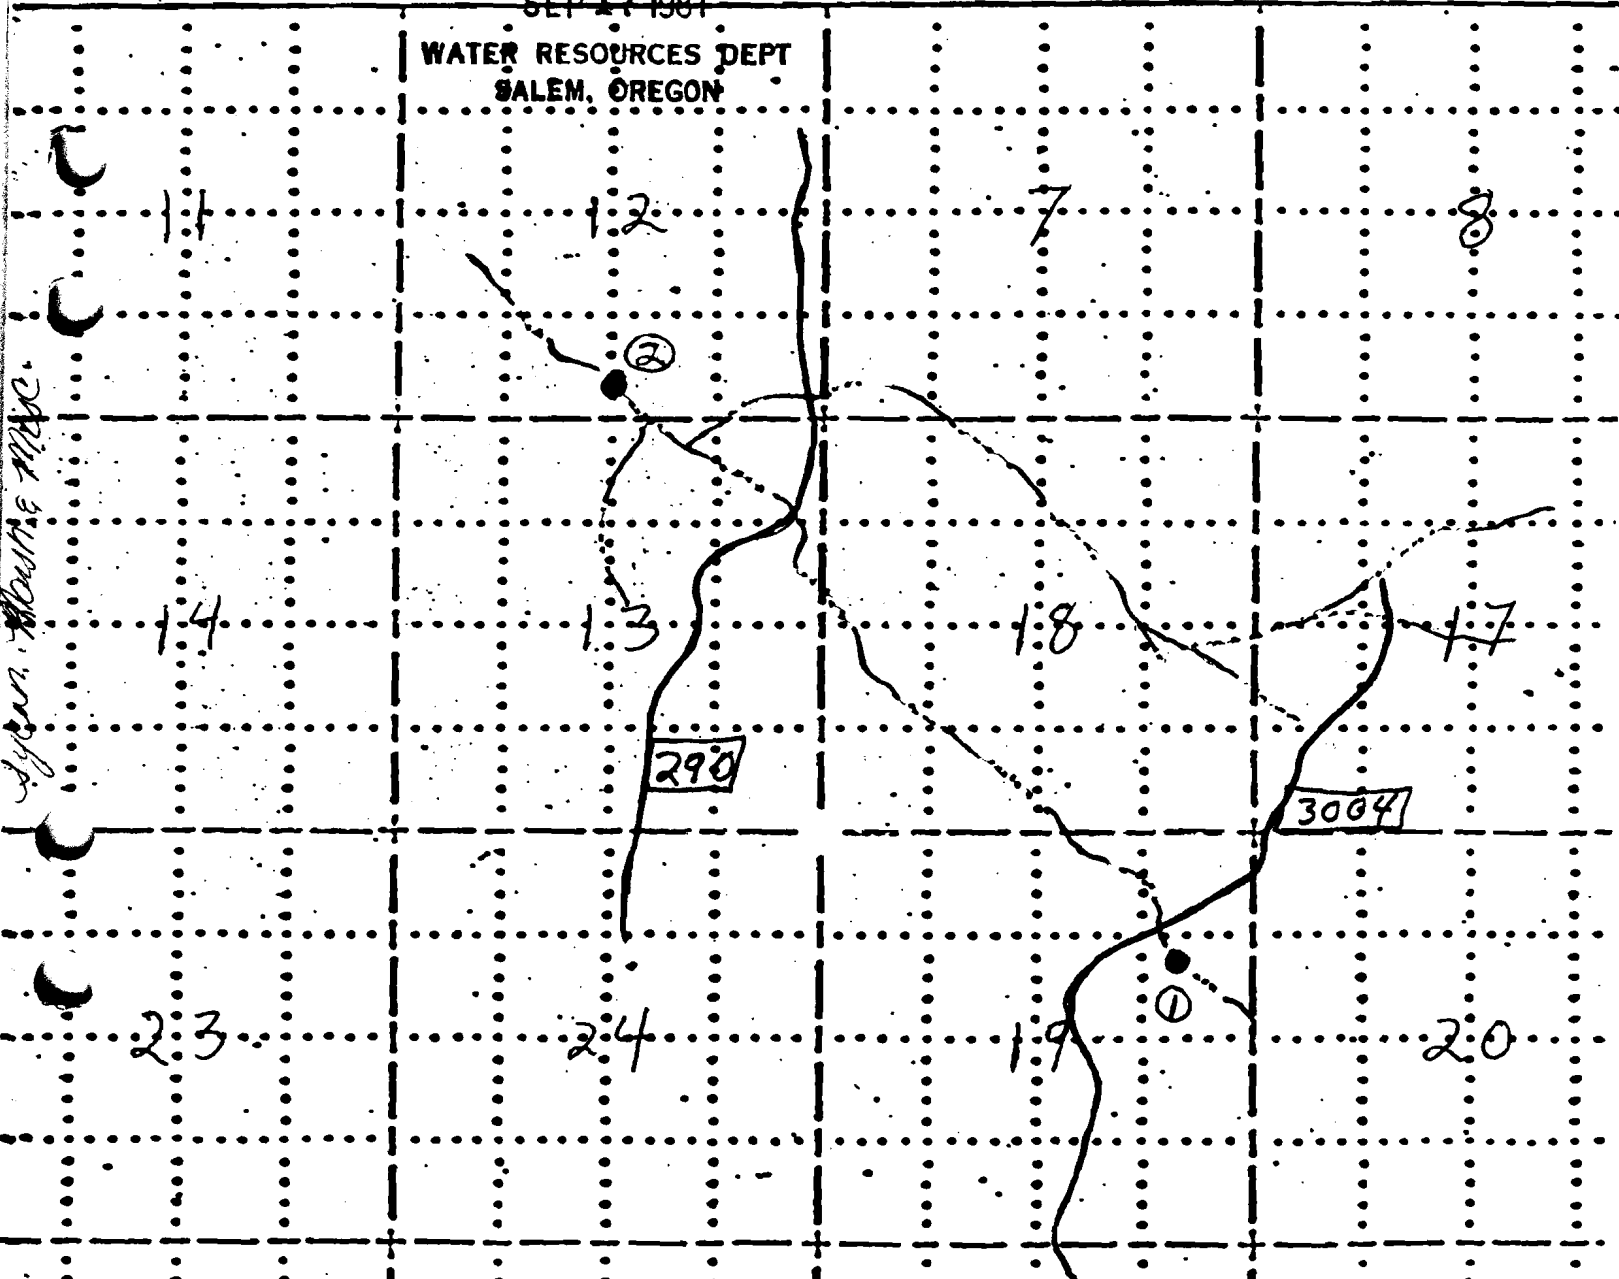


Sycamore Mountain

RECEIVED

AUG 17 1983

WATER RESOURCES DEPT.
SALEM, OREGON

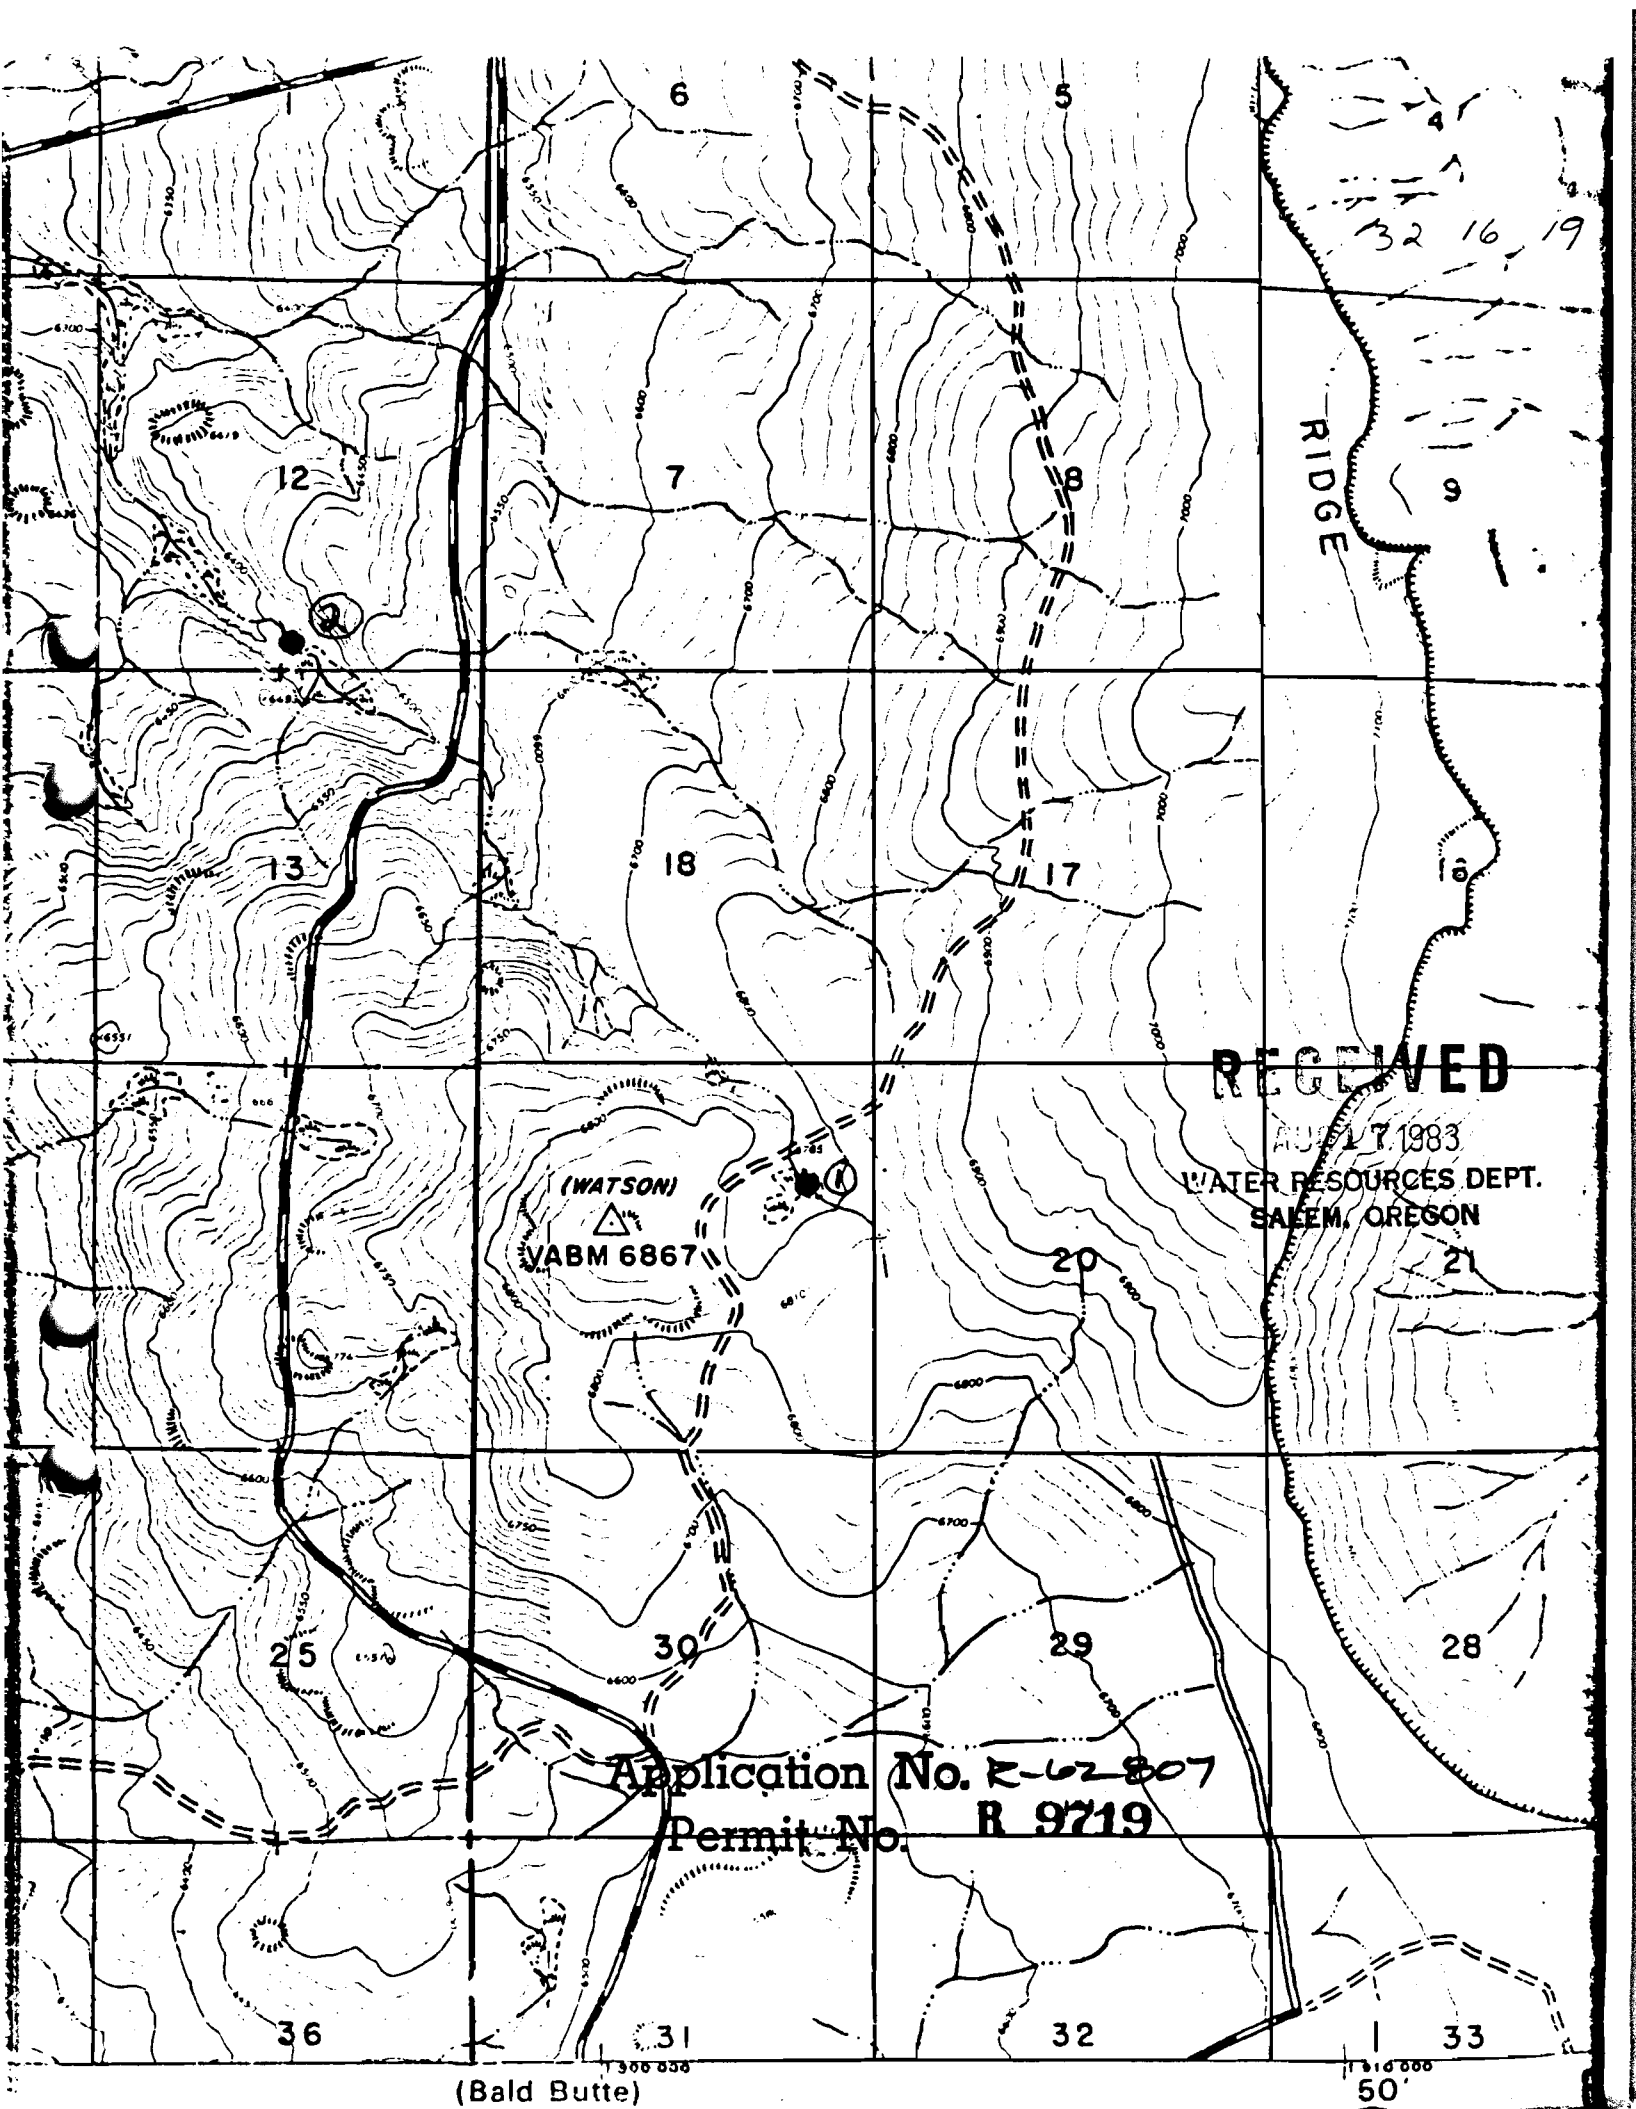

32 16 19

RIDGE

RECEIVED

AUG 17 1983

WATER RESOURCES DEPT.
SALEM, OREGON

(WATSON)
VABM 6867

Application No. R-62807

Permit No. R 9719

(Bald Butte)

50'