


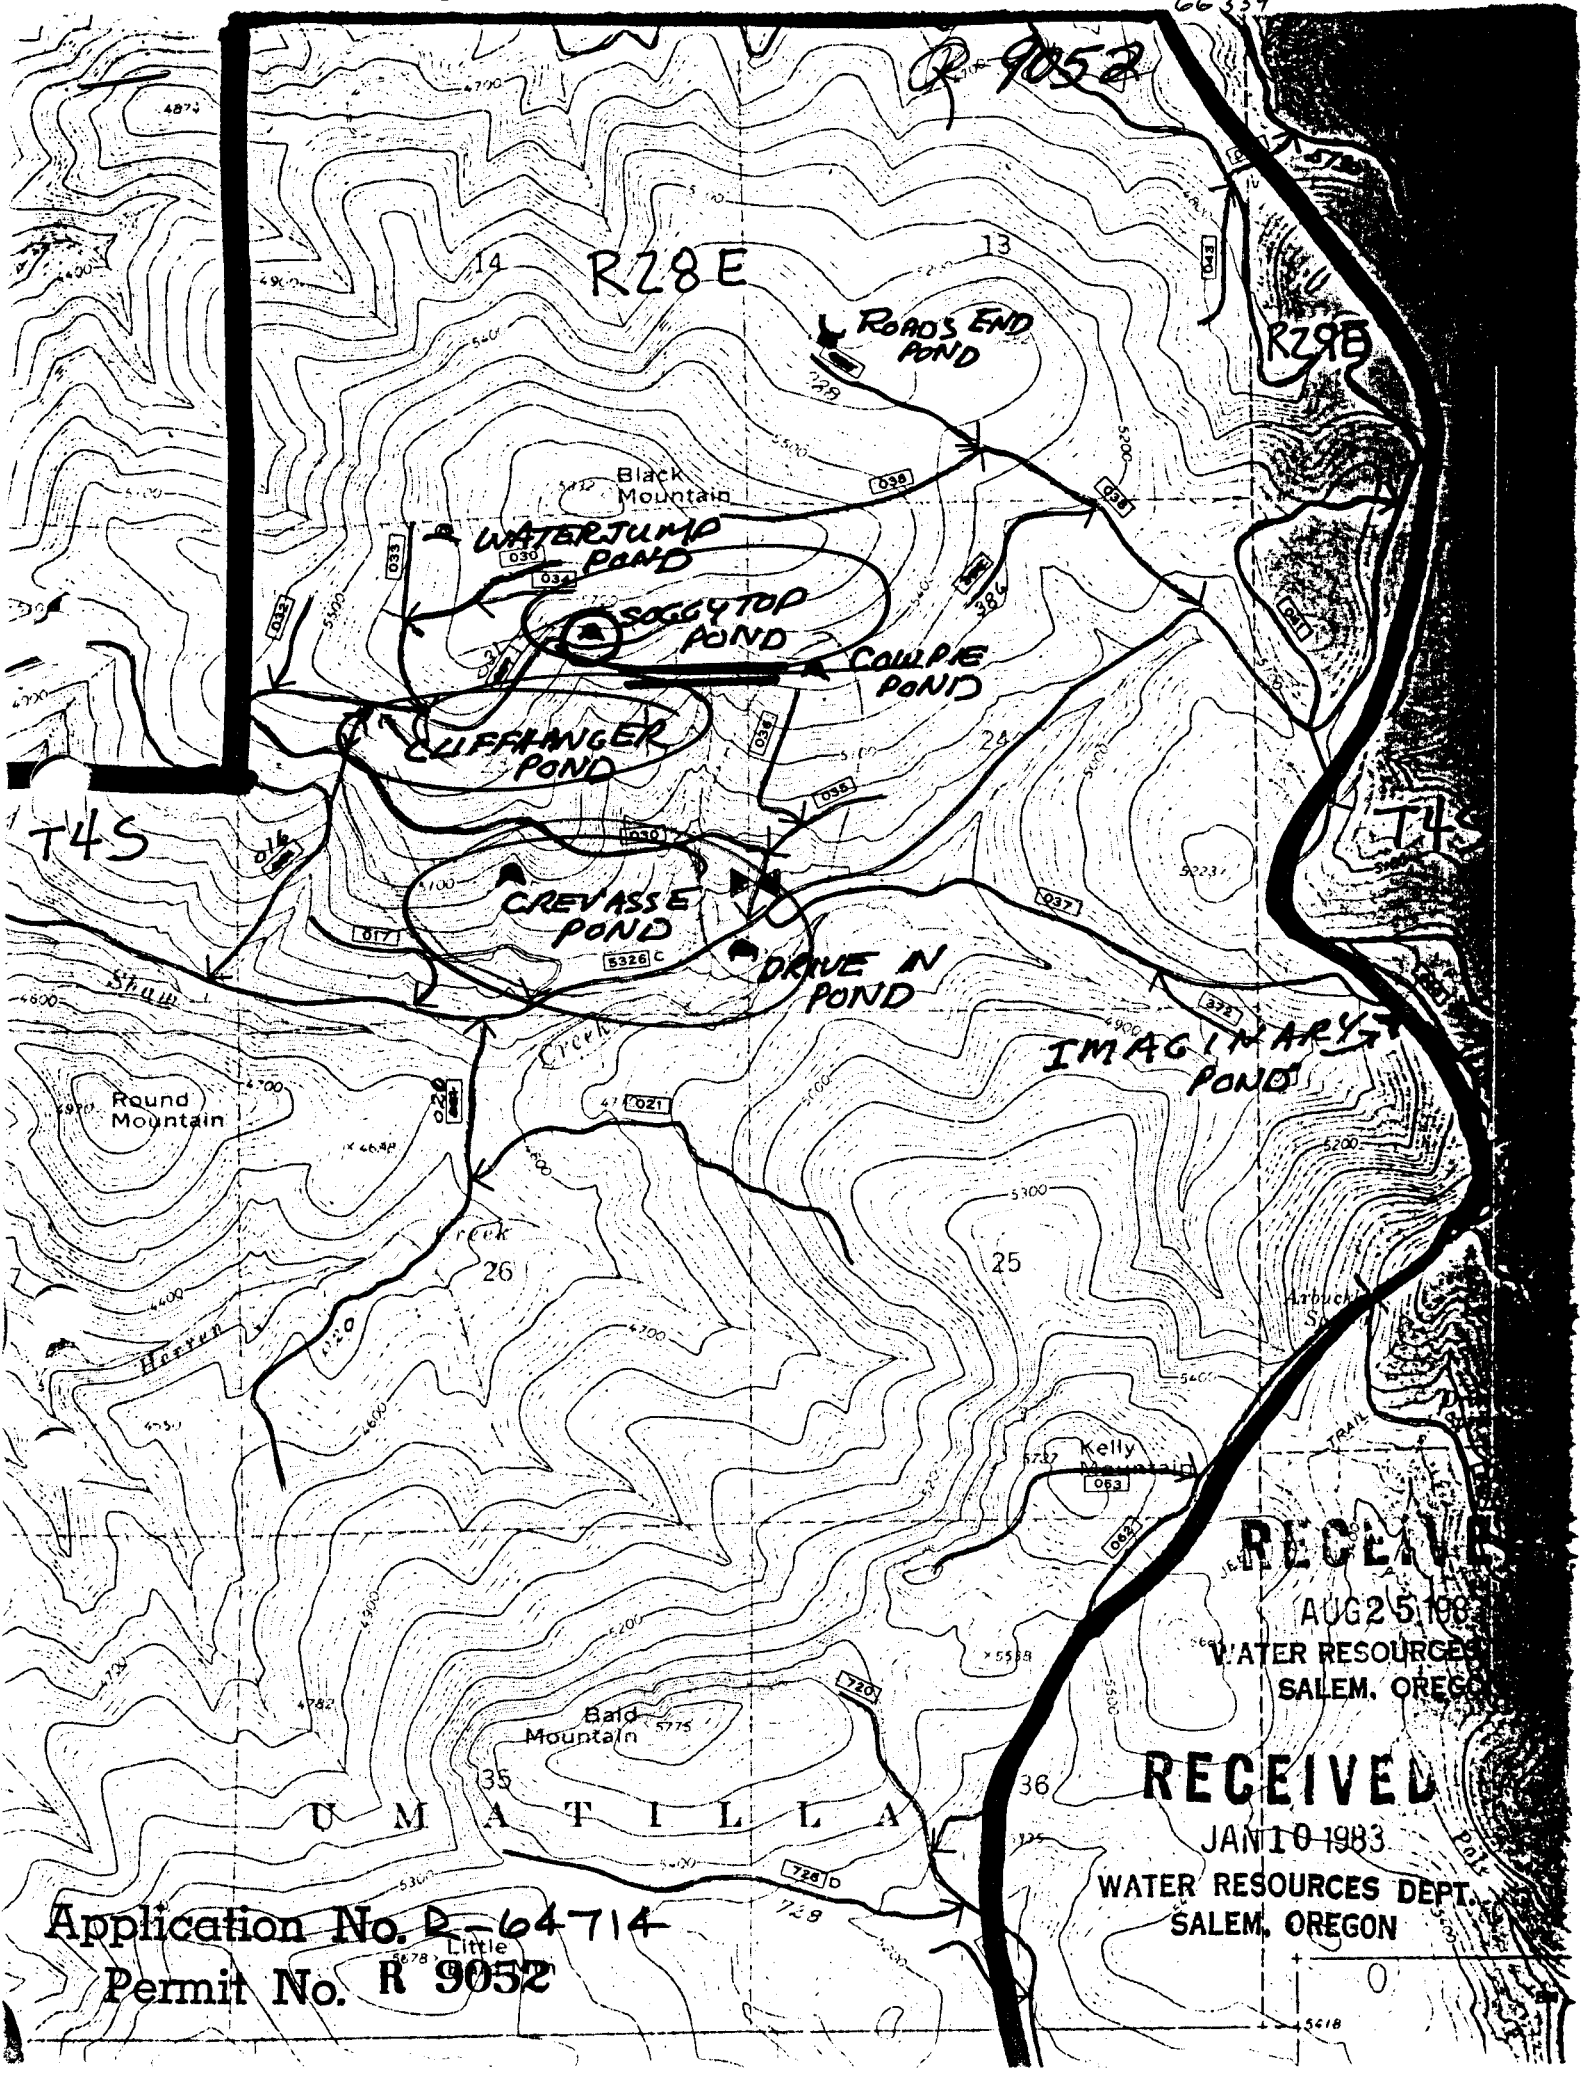

R 9052

R28E

R29E

T4S

T4

U M A T I L L A

Application No. R-64714

Permit No. R 9052

RECEIVED

AUG 25 1982

WATER RESOURCES
SALEM, OREGON

RECEIVED

JAN 10 1983

WATER RESOURCES DEPT.
SALEM, OREGON

SALEM, OREGON

R9052

TOWNSHIP 45, RANGE 28E, SECTION 23, W.M.

14

13

750'
1650'

23

24

NAME SOGGY TOP PD.

COUNTY MORROW

Application No. R-64714

Permit No.

R 9052

RECEIVED

JAN 10 1983

RECEIVED

AUG 25 1983

WATER RESOURCES DEPT.

SALEM, OREGON

WATER RESOURCES DEPT.

SALEM, OREGON

3A