

66340
R-9056
1 of 3

TOWNSHIP 7S, RANGE 24E, SECTION 4, W.M.

33

34

4



3

NAME LOWER STAHL POND

COUNTY WHEELER

RECEIVED

JAN 10 1983

Application No. R-64720

3B

RECEIVED

WATER RESOURCES DEPT.
SALEM, OREGON

Permit No. R 9056

AUG 25 1983
WATER RESOURCES DEPT.
SALEM, OREGON

R-9056

TOWNSHIP 7S, RANGE 24E, SECTION 3, W.M.

4

3

9

10

NAME EAST STAHL POND

COUNTY WHEELER

Application No. R-64720

3A

Permit No. R 9056

RECEIVED

JAN 10 1983


WATER RESOURCES DEPT.

AUG 25 1983

SALEM, OREGON

WATER RESOURCES DEPT.

SALEM, OREGON

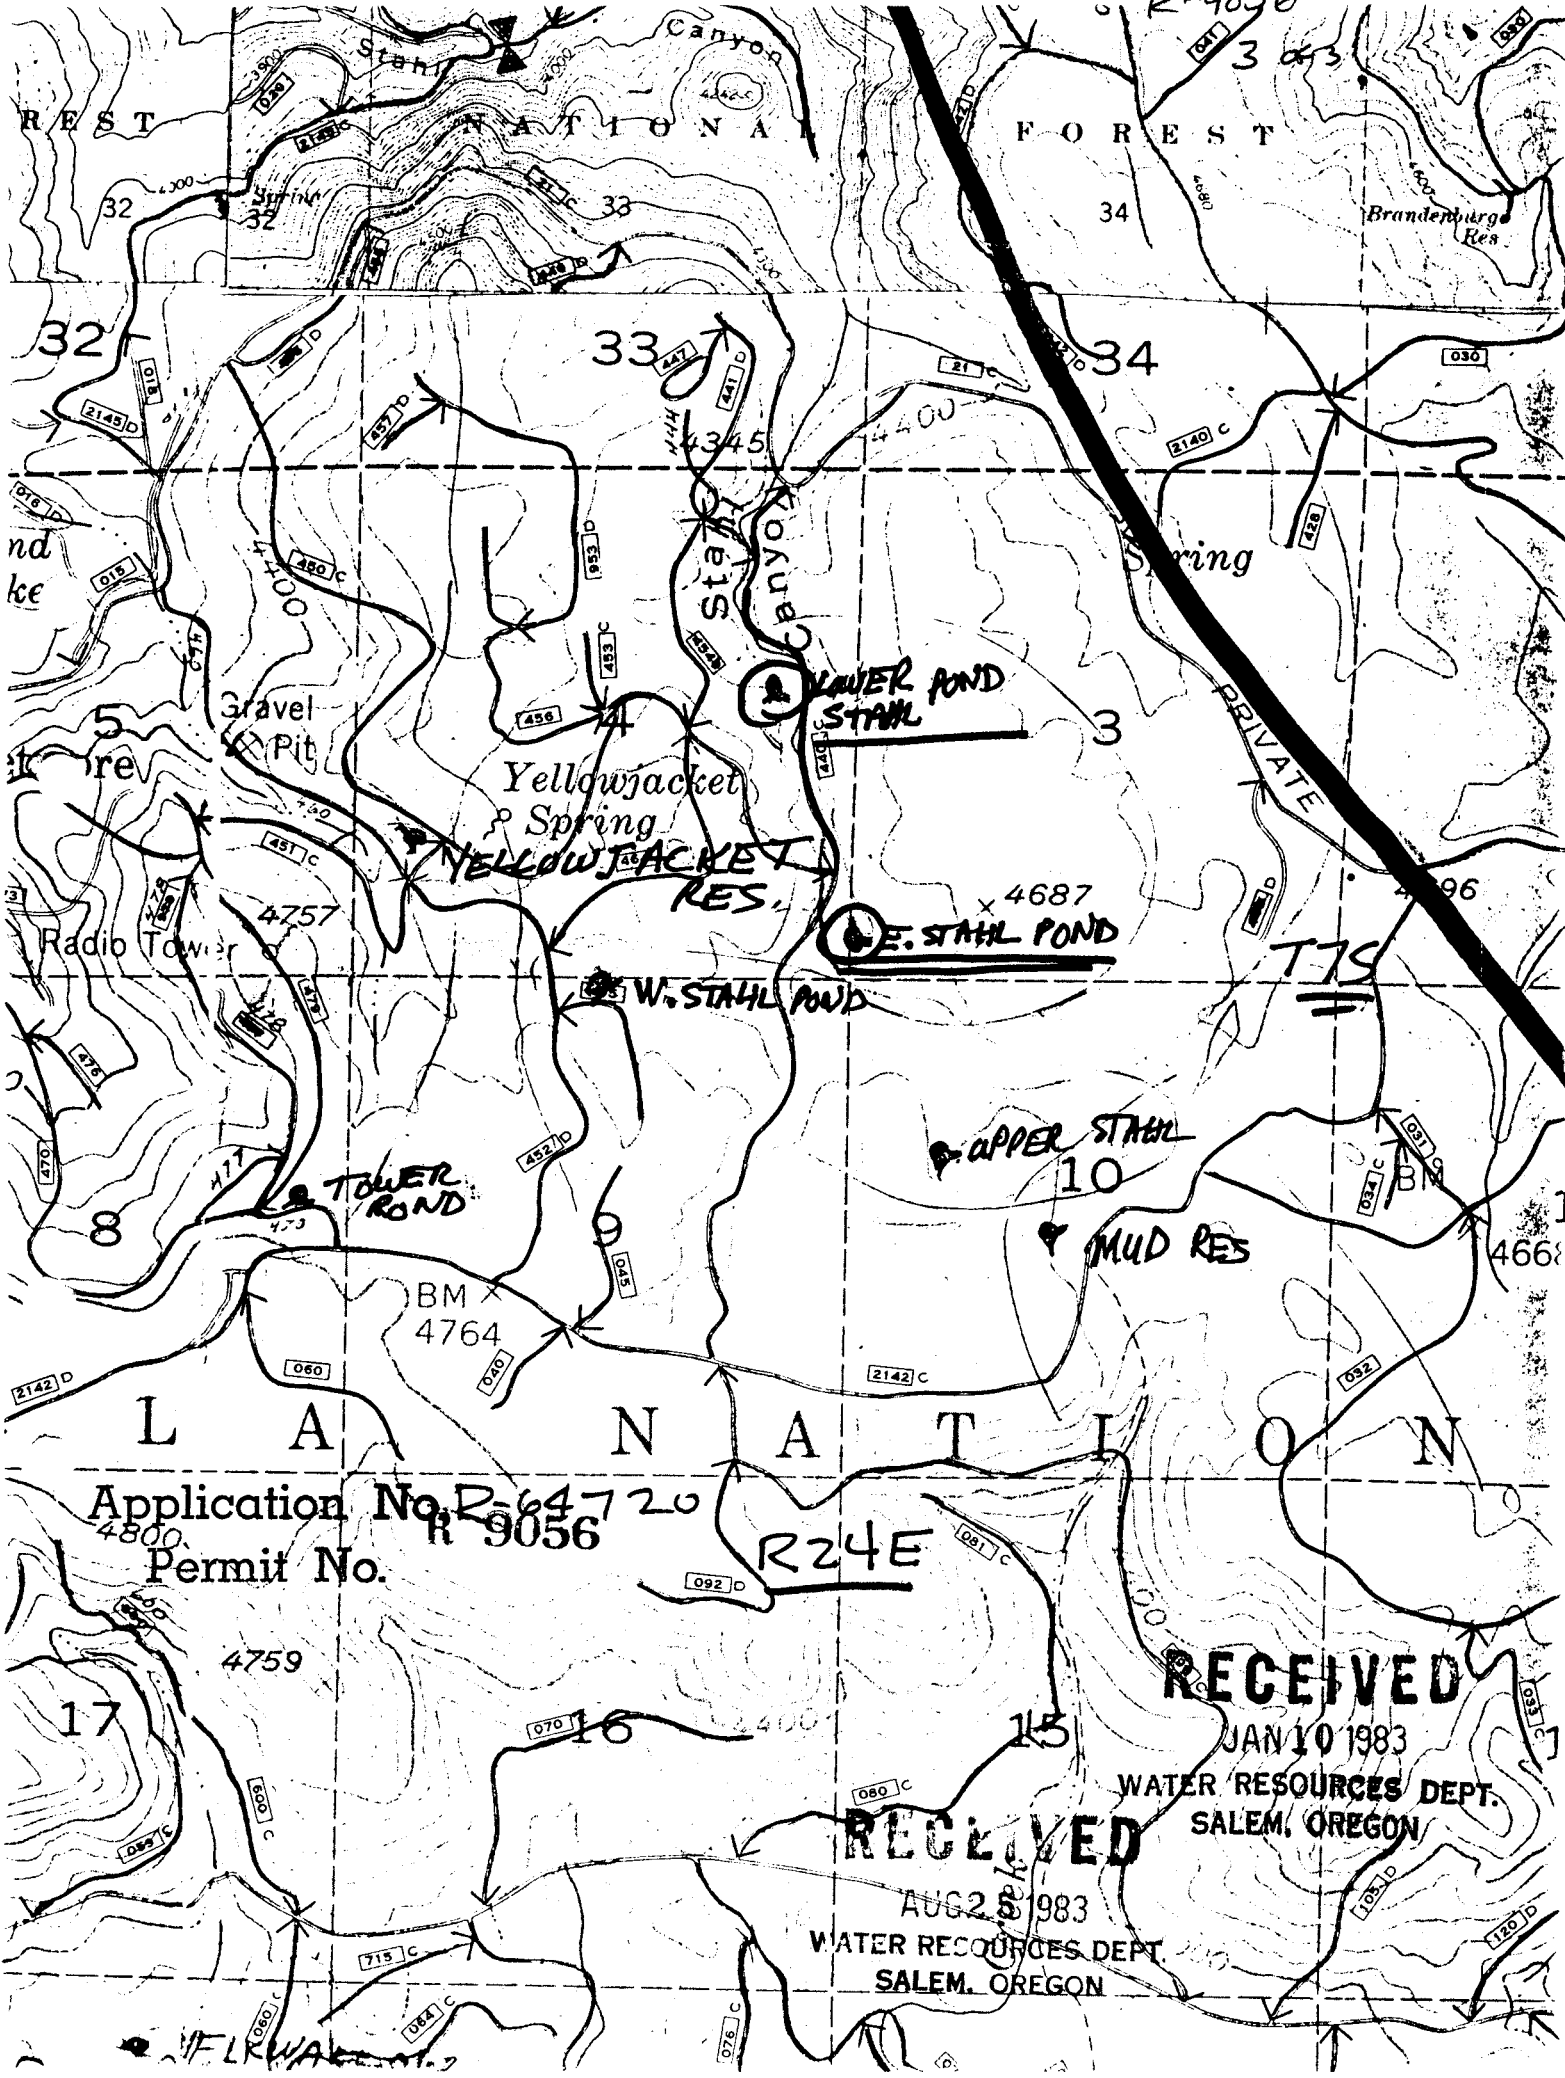

Application No. **R64720**
Permit No. **R9056**

RECEIVED

JAN 10 1983

WATER RESOURCES DEPT.
SALEM, OREGON

RECEIVED

AUG 28 1983

WATER RESOURCES DEPT.
SALEM, OREGON