

T-6 S
R-32E
SECTION 69
9

Rose
Spring

Drift Fence
Campground

Canyon


Bridge

Creek



RECEIVED

R 10534 10PZ

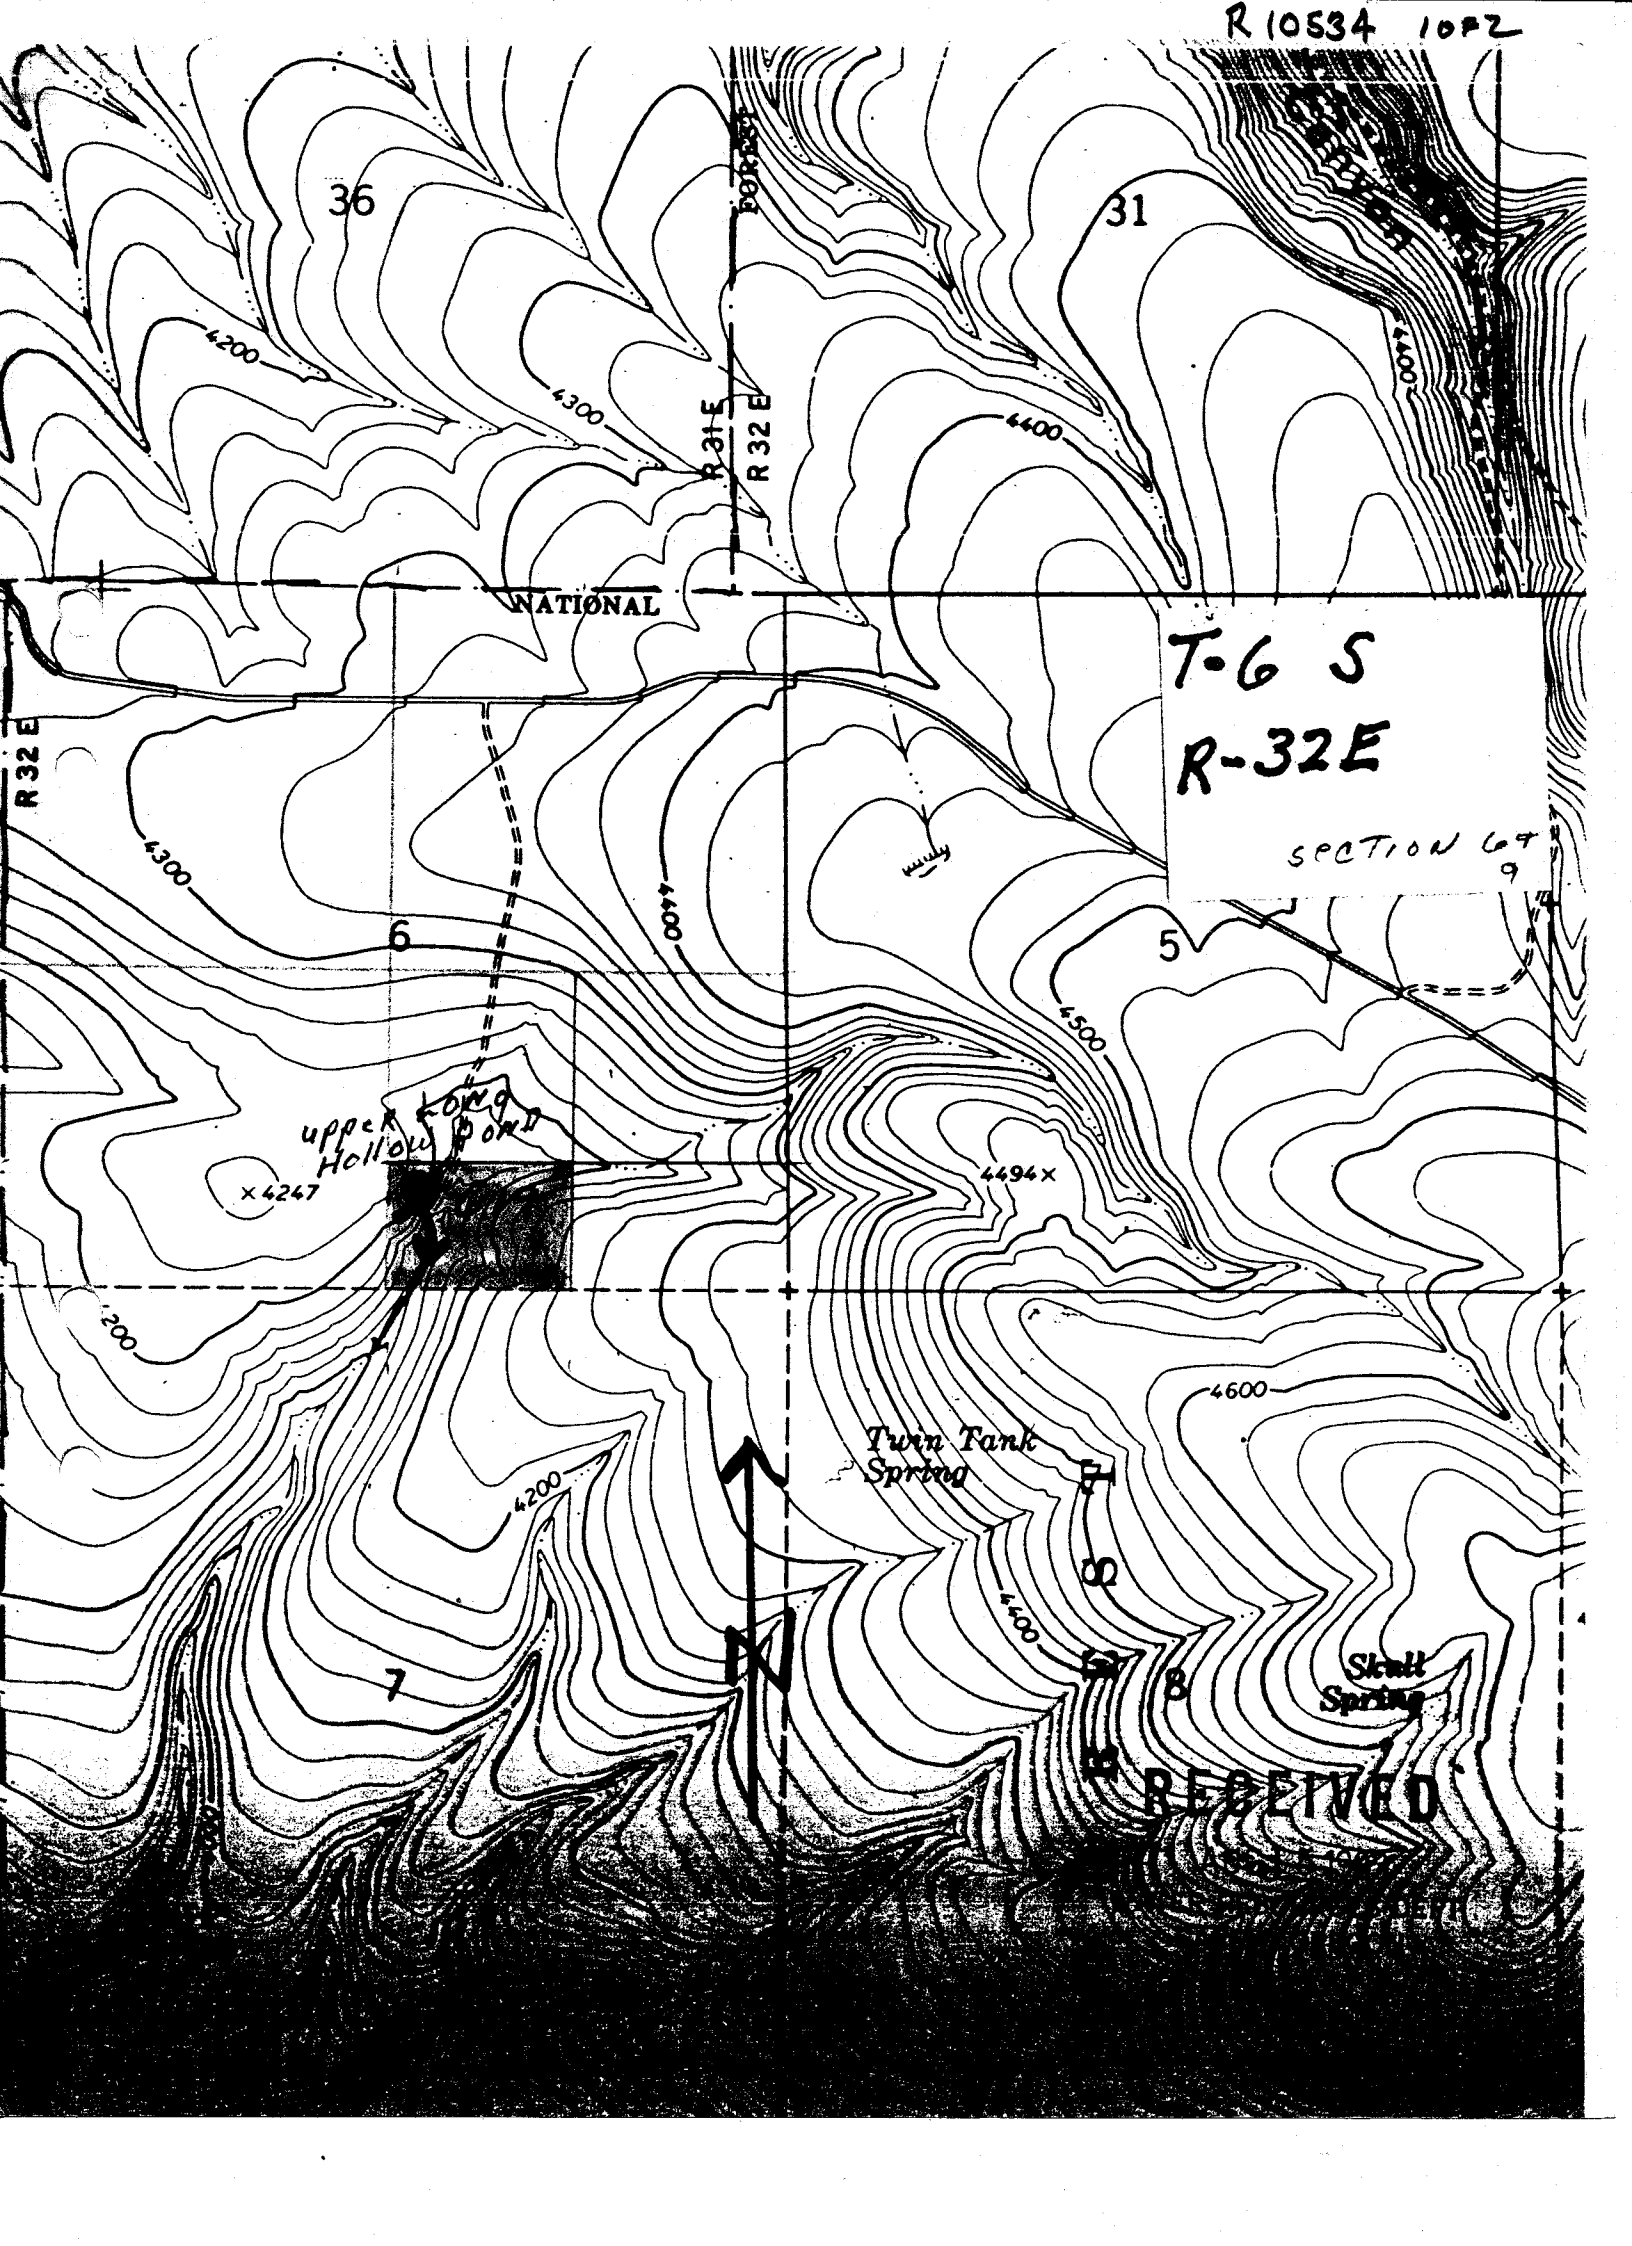

36

31

NATIONAL

T-6 S
R-32E

SECTION 67
9

upper Long
Hollow Pond

x 4247

4494x

Turn Tank
Spring

Skull
Spring

RECEIVED

