


RECEIVED

WATER RESOURCES DEPT.
SALEM, OREGON

Application No. R-65542
Permit No. R10543

T6S
R32E

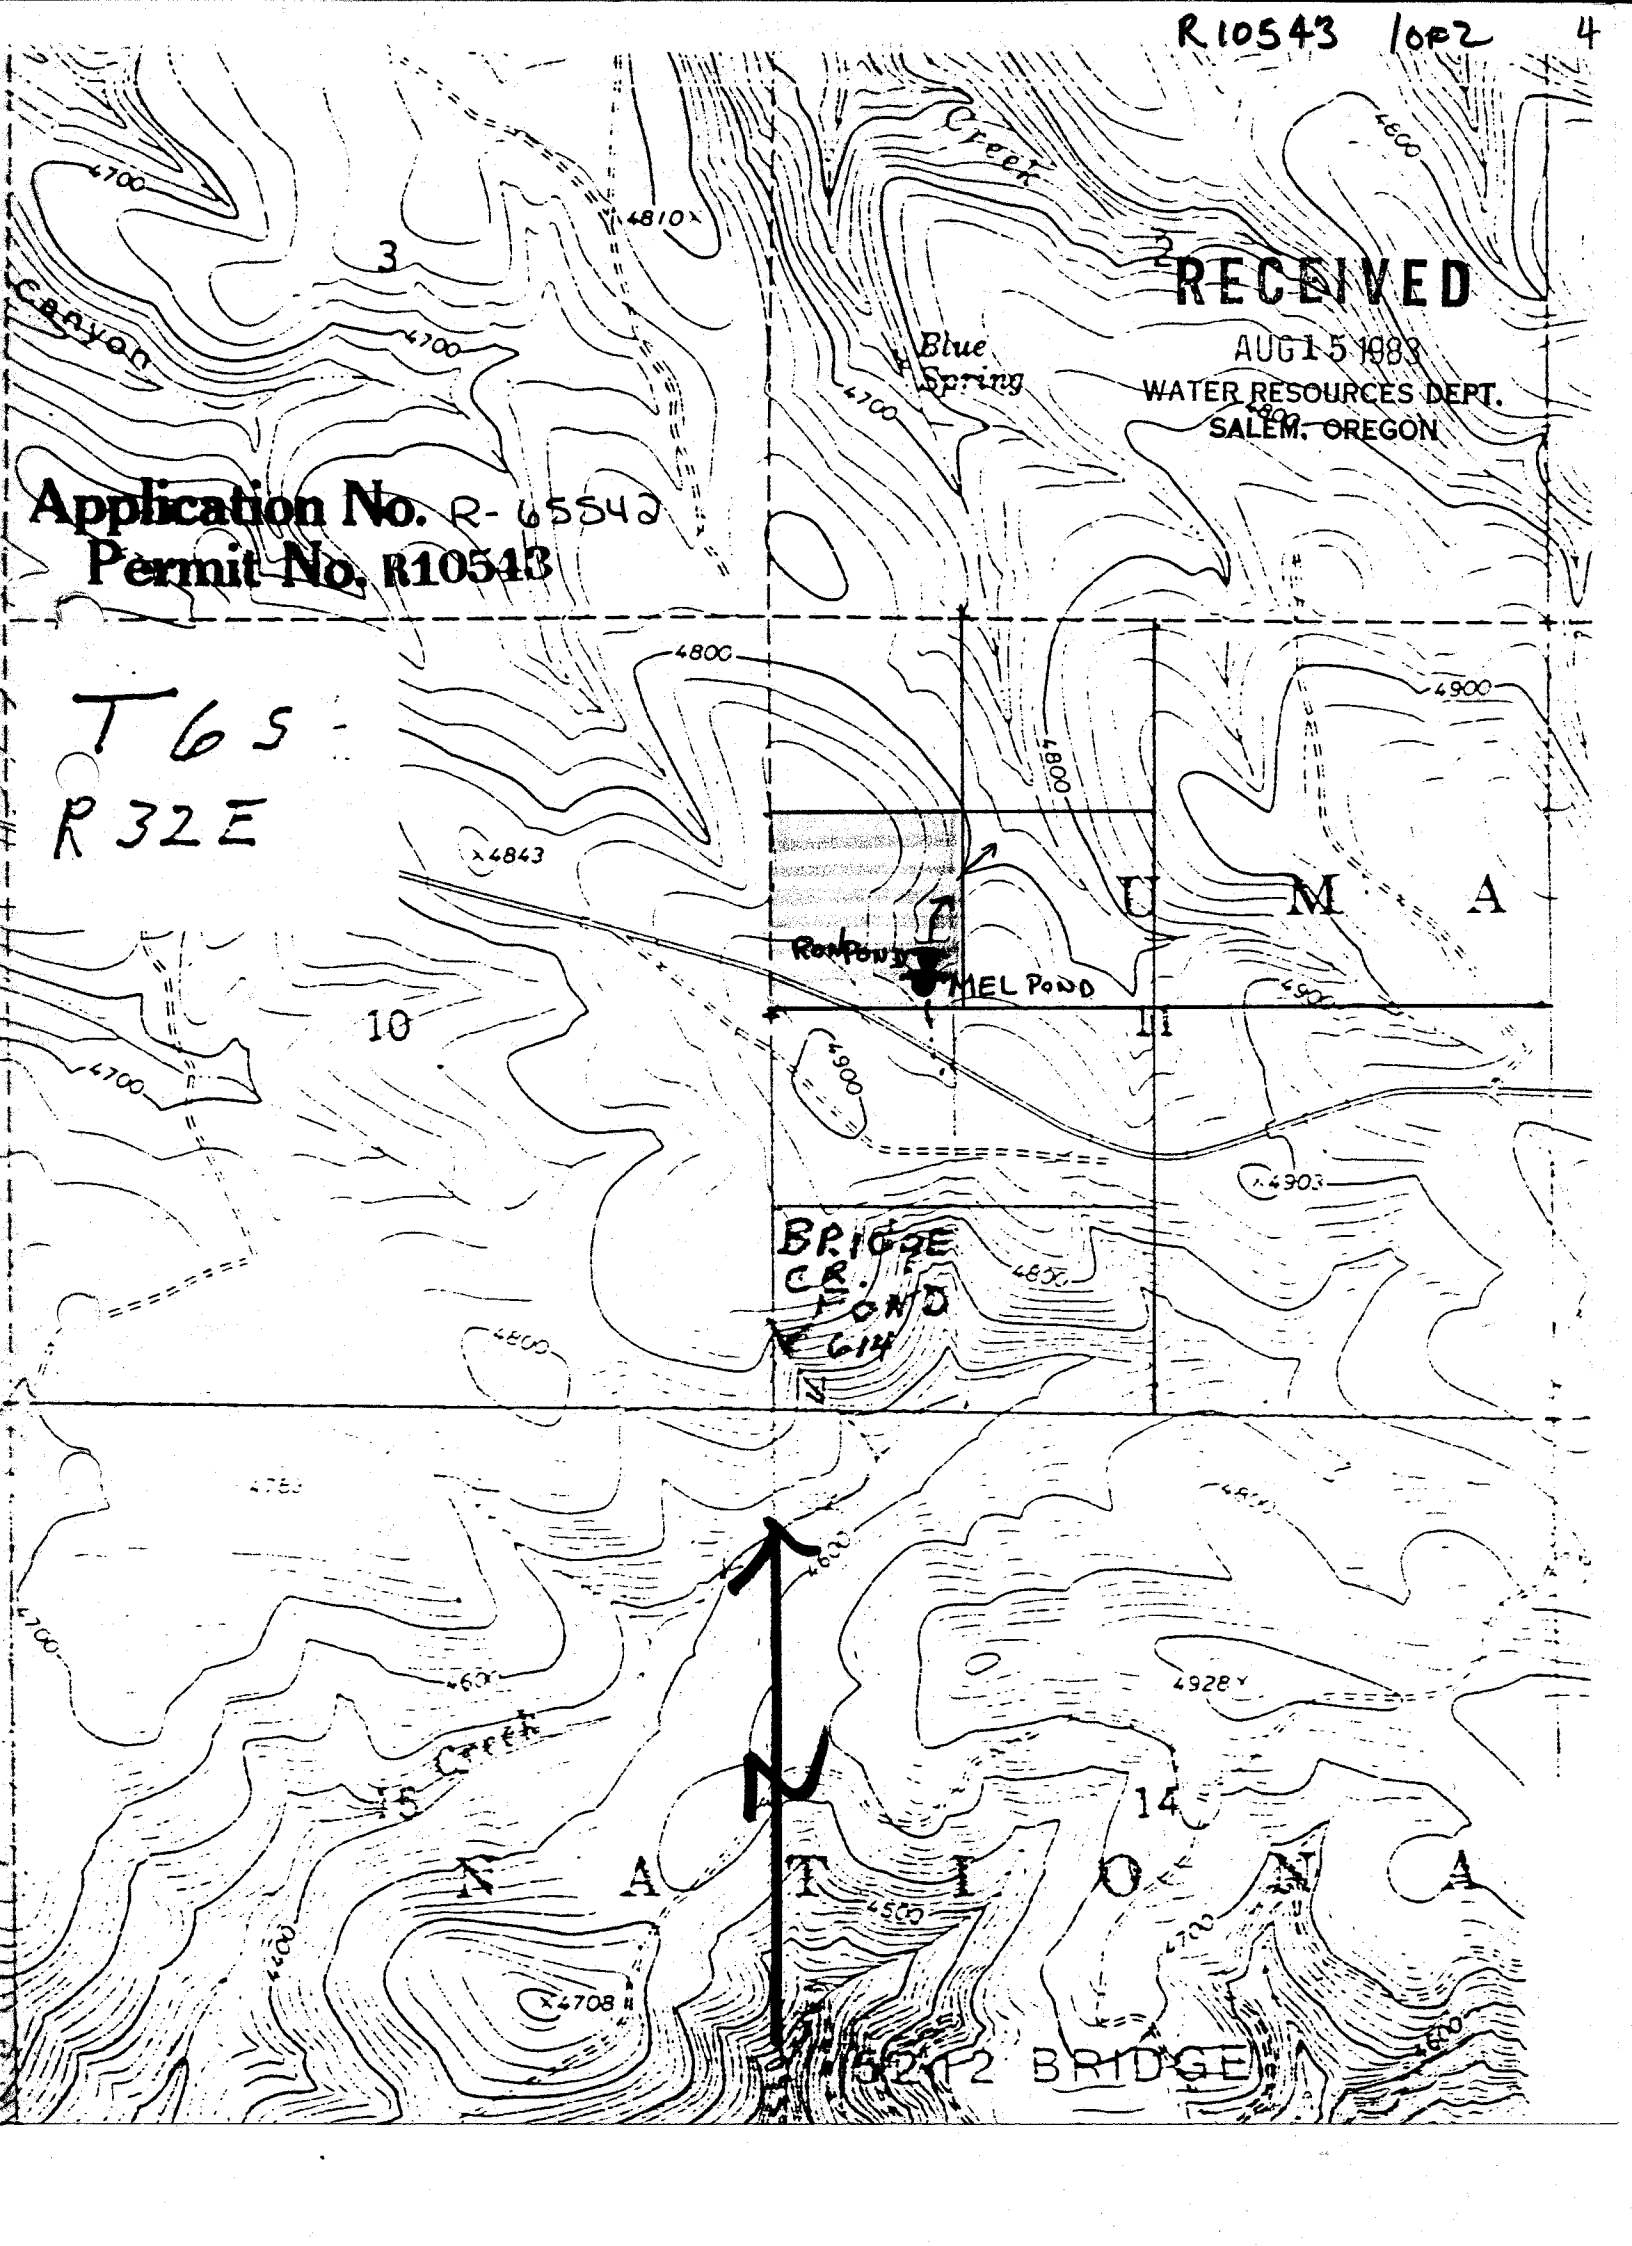

BRIDGE