


SECTION 24
SW SW

09-4645
CANYON RES.

TOWNSHIP 33S, RANGE 32E, W. M.

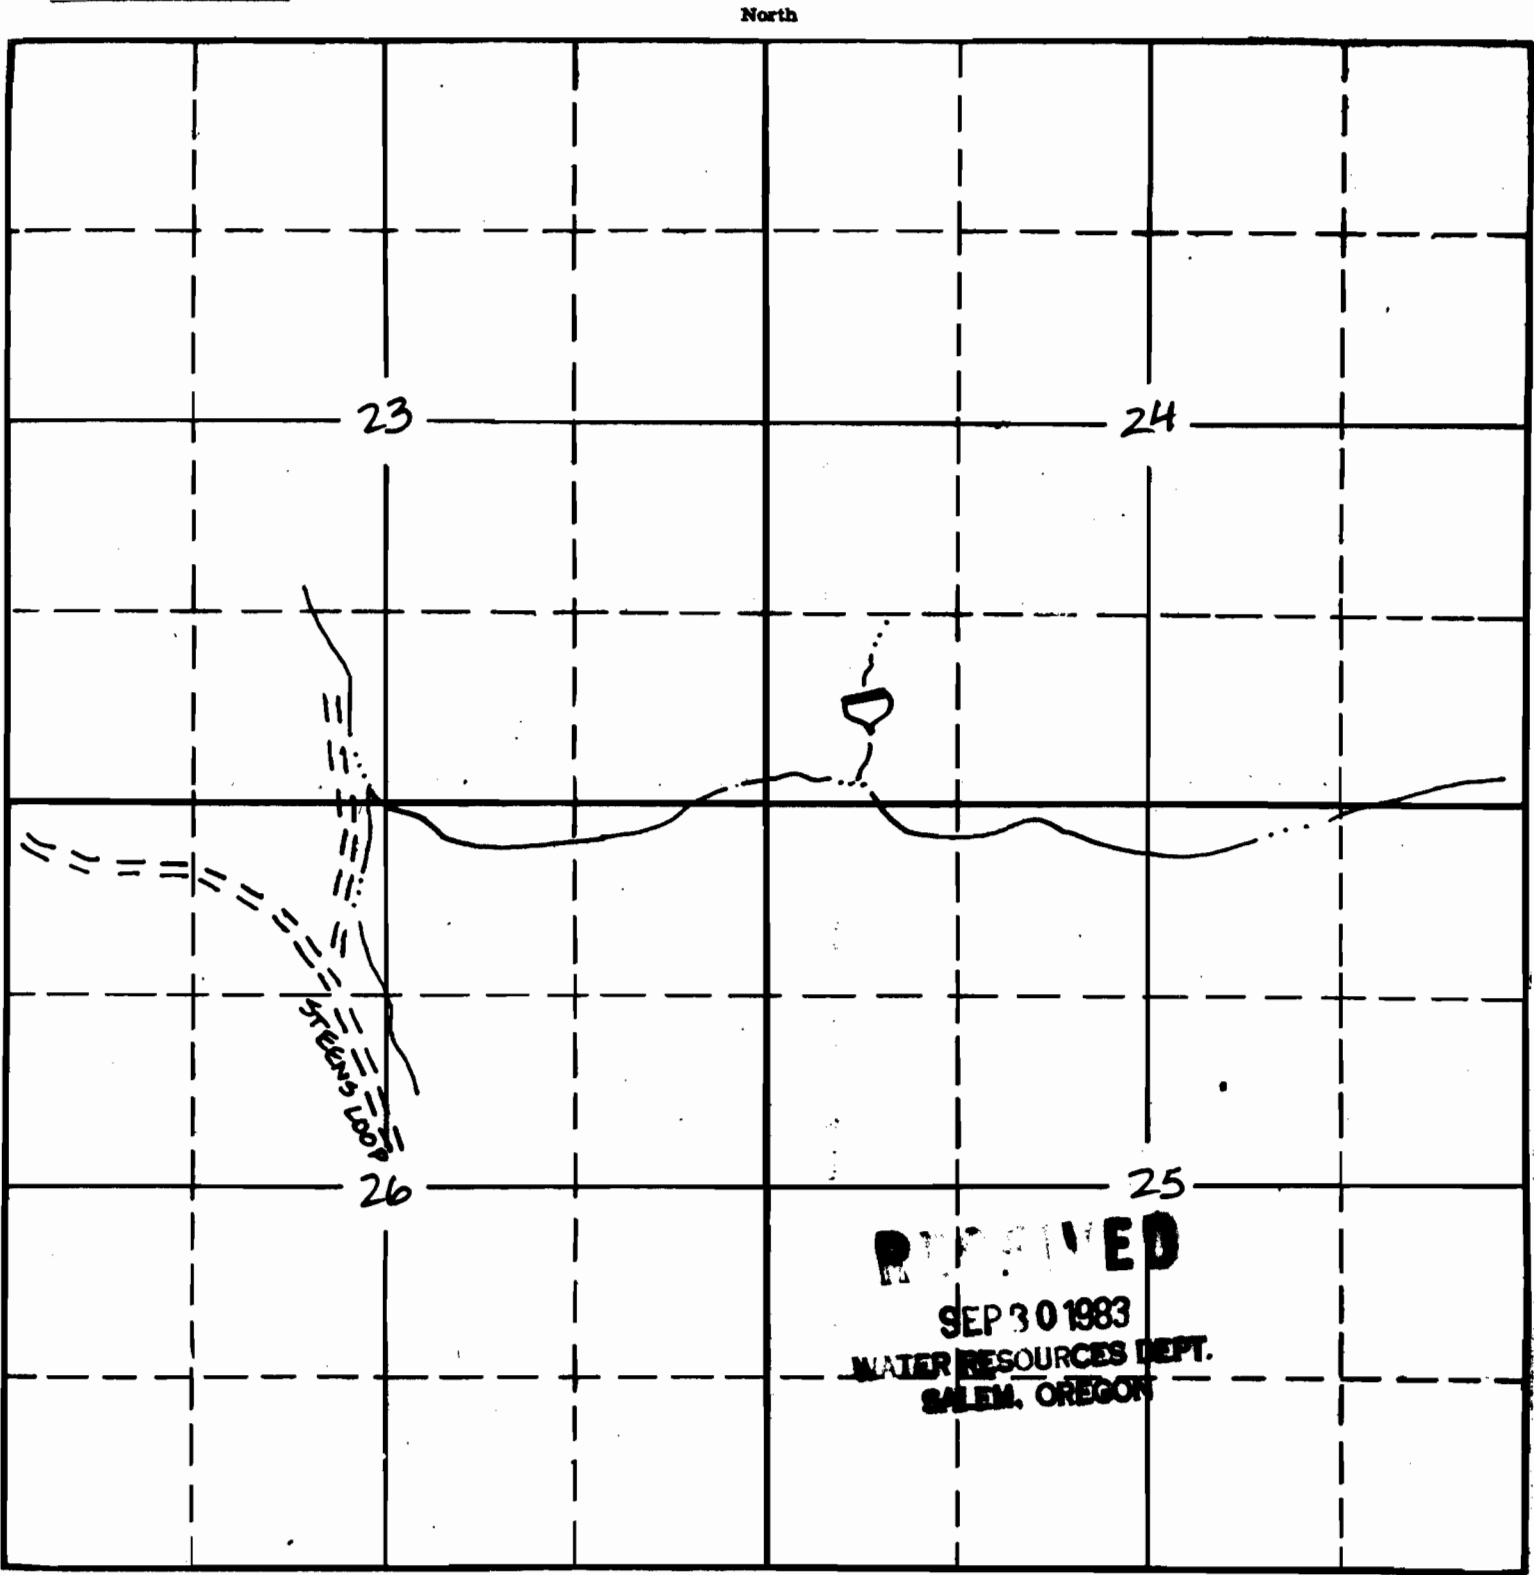

RECEIVED
SEP 30 1983
WATER RESOURCES DEPT.
SALEM, OREGON

R-67031
APPLICATION No.
PERMIT No.
R10358