

UNITED STATES
DEPARTMENT OF THE INTERIOR
BUREAU OF LAND MANAGEMENT

SECTION


20

Oregon State Water Filings

NE 1/4 NE 1/4

TOWNSHIP 38 S, RANGE 26 E, W. M.

Tied in with aerial photos and O. S. H. D. Quad Maps

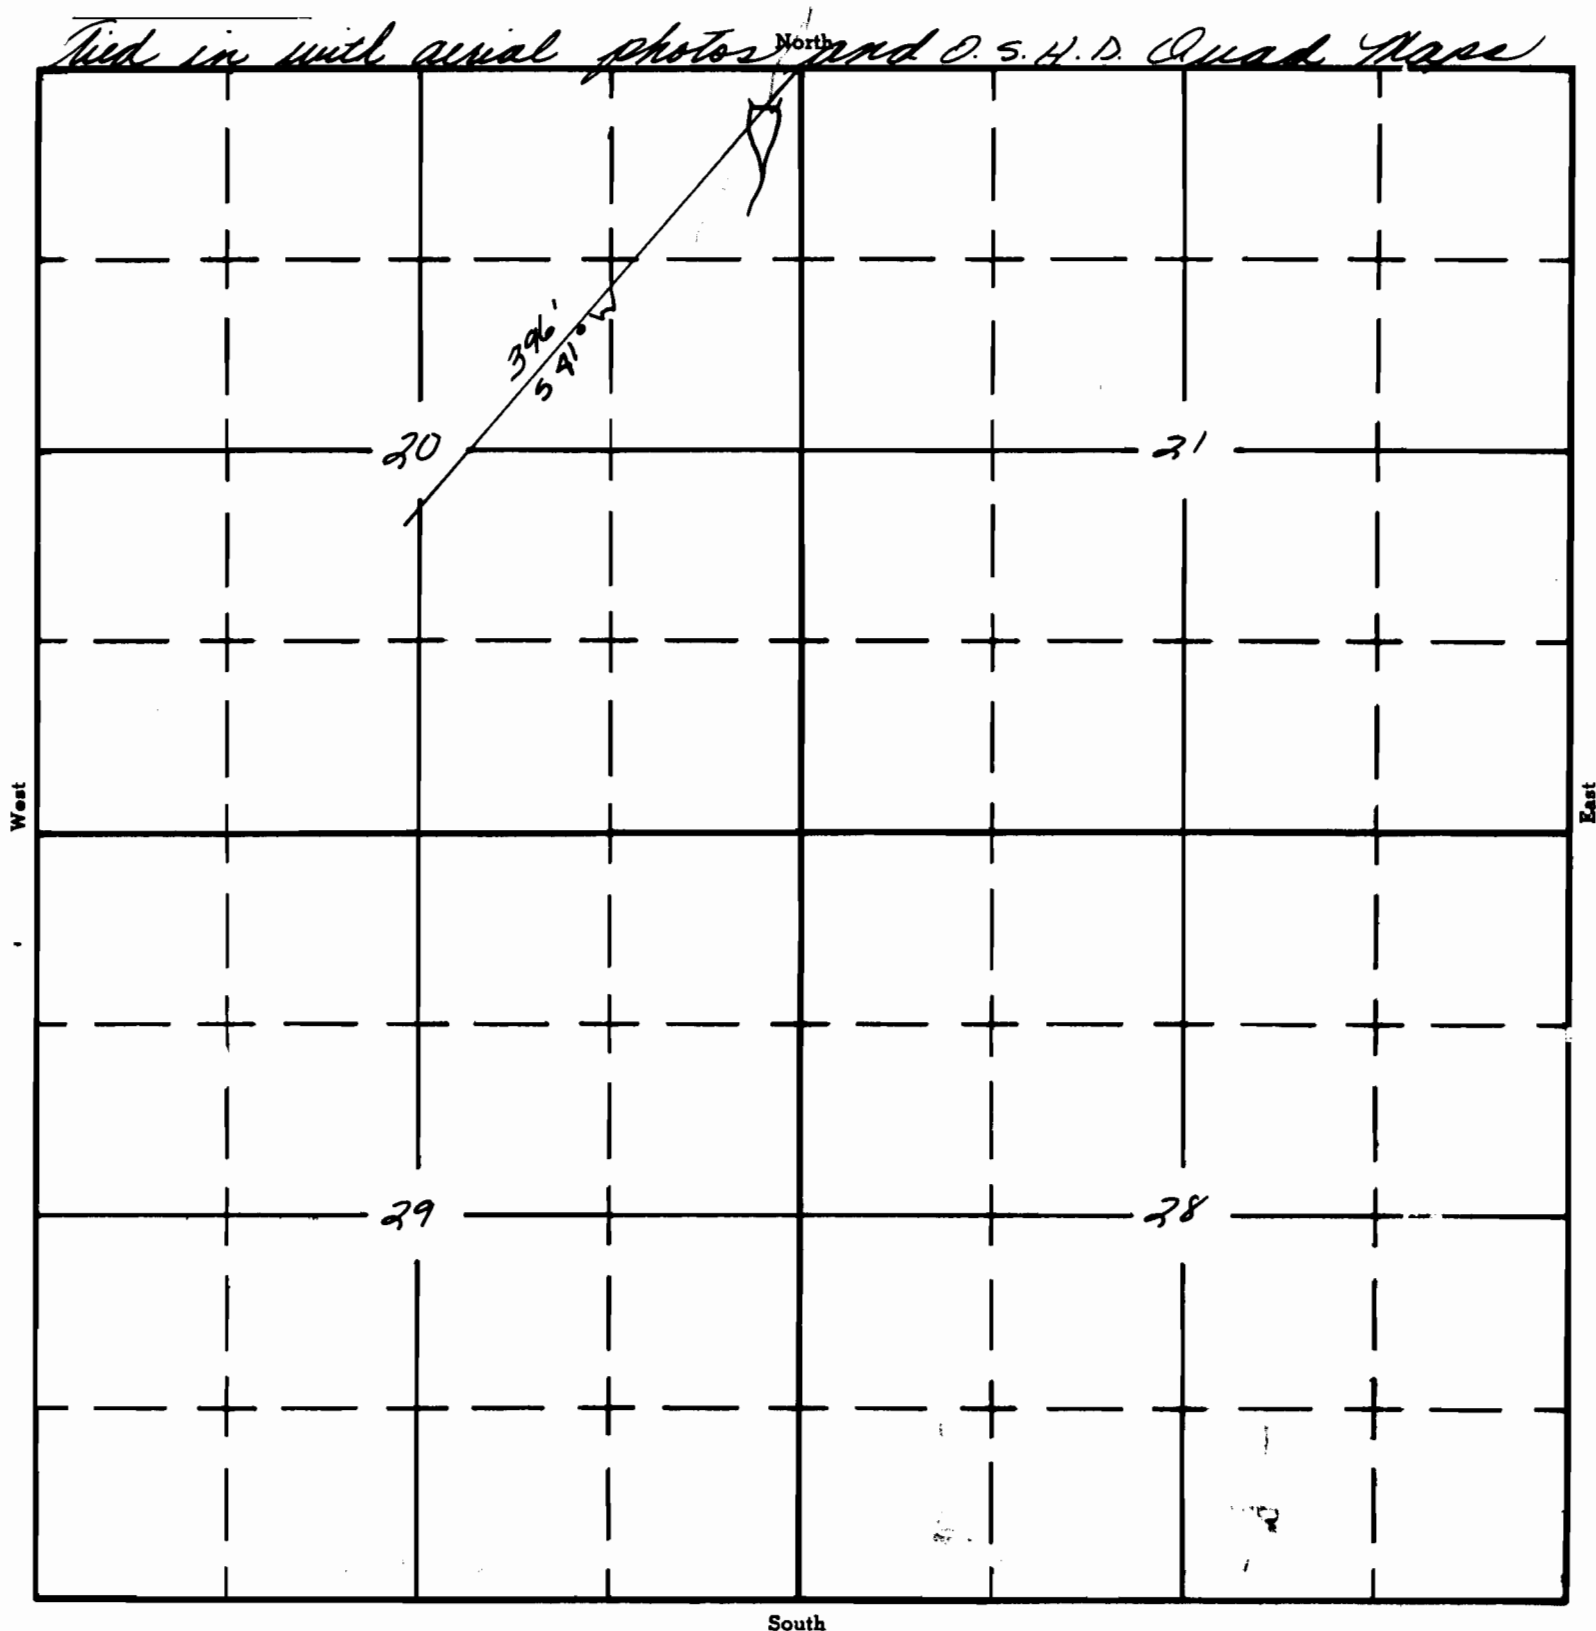

APPLICATION No. R-35788
PERMIT No. R-4076