

RECEIVED

AUG 19 1981

R-8944

FIELD MAP SHEET

WATER RESOURCES DEPT 66375

SALEM, OREGON

FREMONT

N.F.


T. 375 R. 16E/17E Sec. Subdiv.

Mapped by T. OLENICHAK Reviewed by Scale 2 inches = 1 Mile

- RESERVOIR
- DRAINAGE
- ROAD

Application No. R-62493 7/8, 1981

Permit No. R 8944

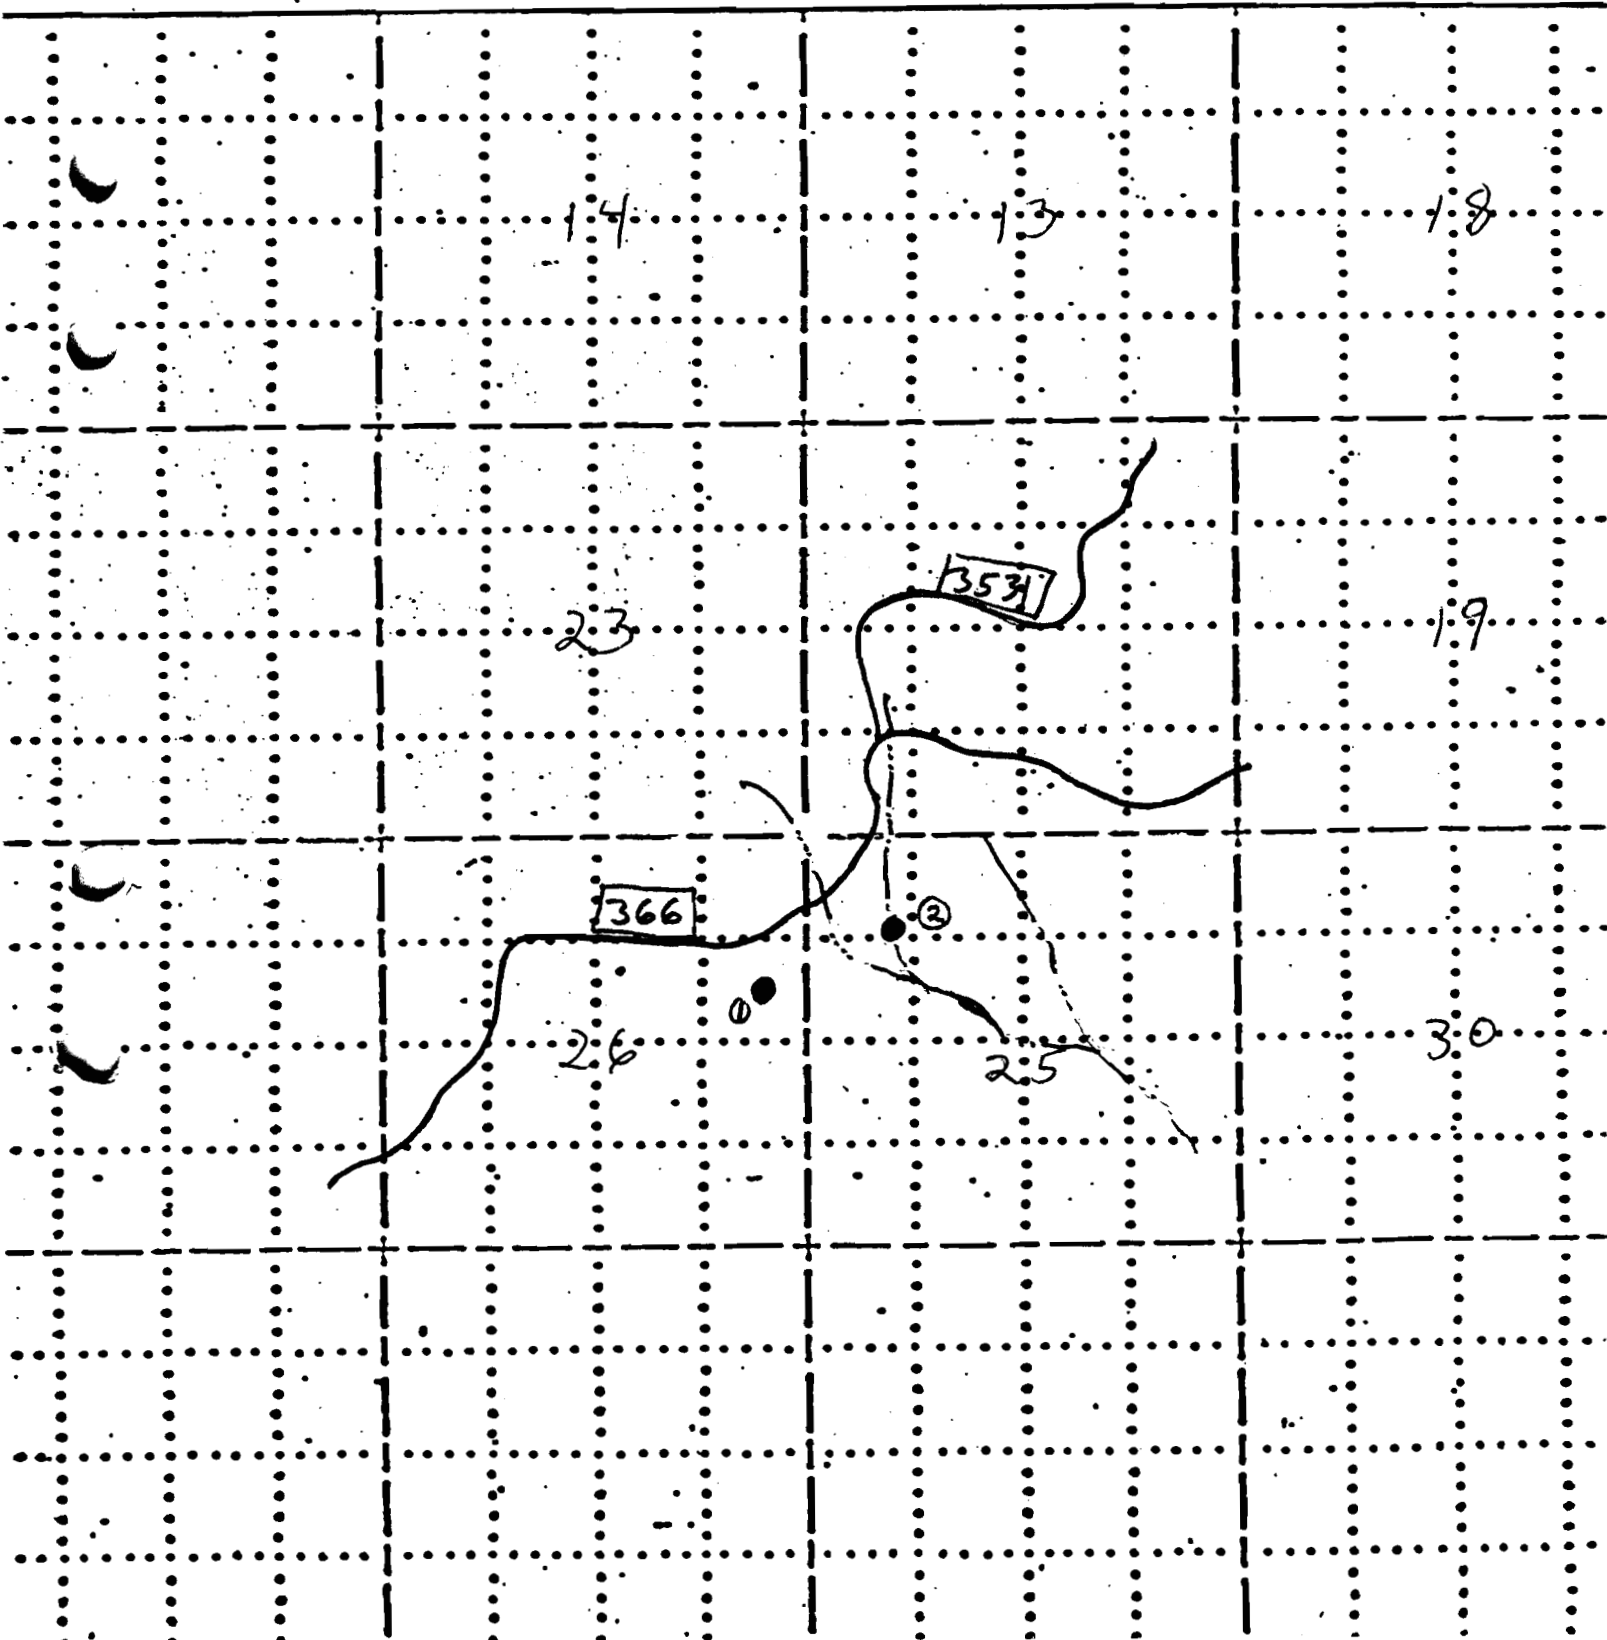

R 8944
66375

37 16 25

RECEIVED


AUG 19 1981

WATER RESOURCES DEPT
SALEM, OREGON

Application No. R-62493

Permit No. R 8944

T. 37 S.

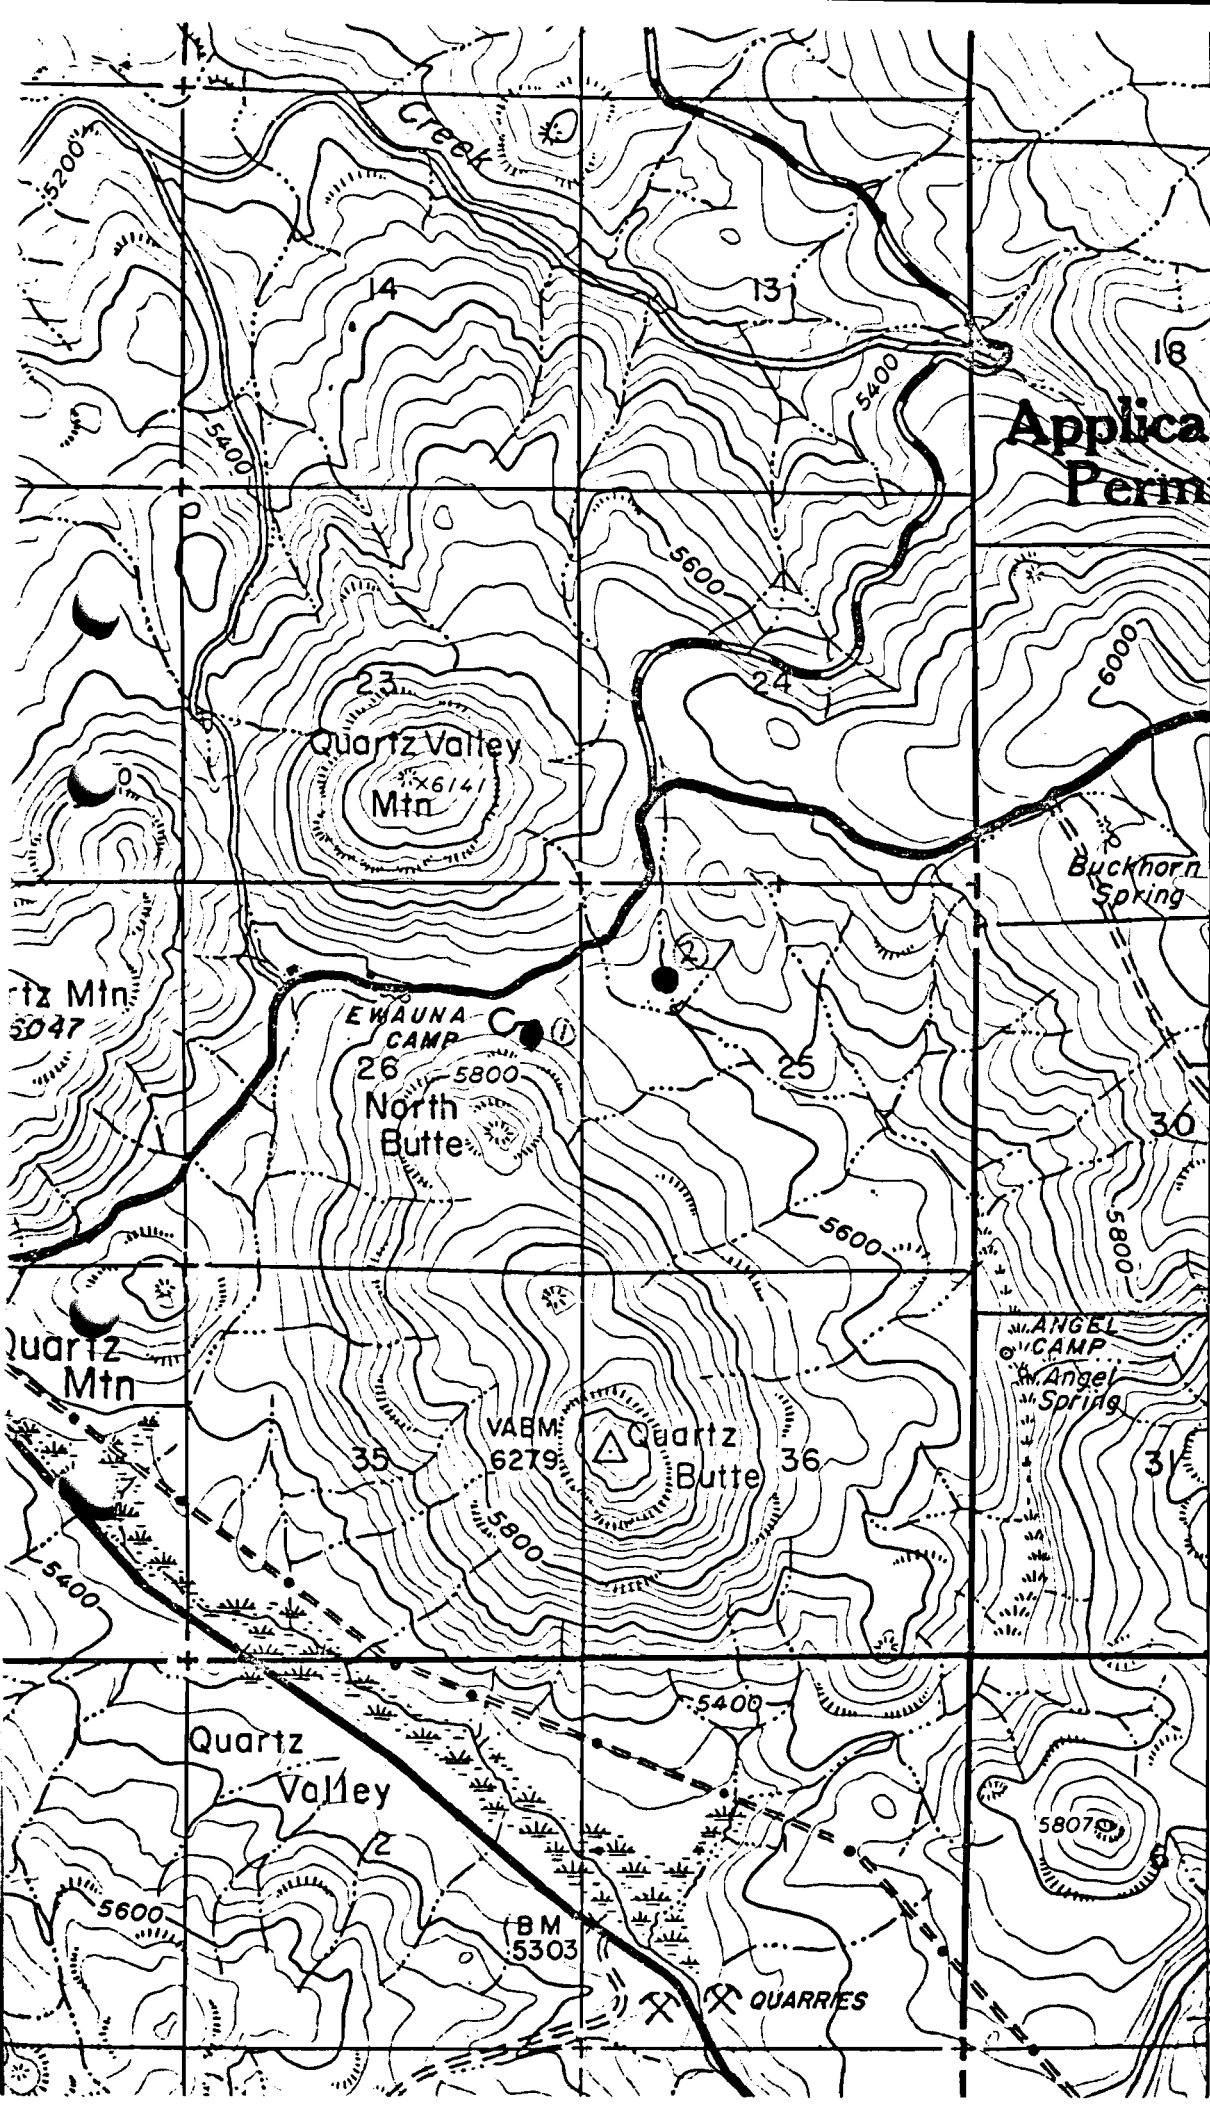

14)

20'

240 000

000 000