


5592

T 17 S 18 E

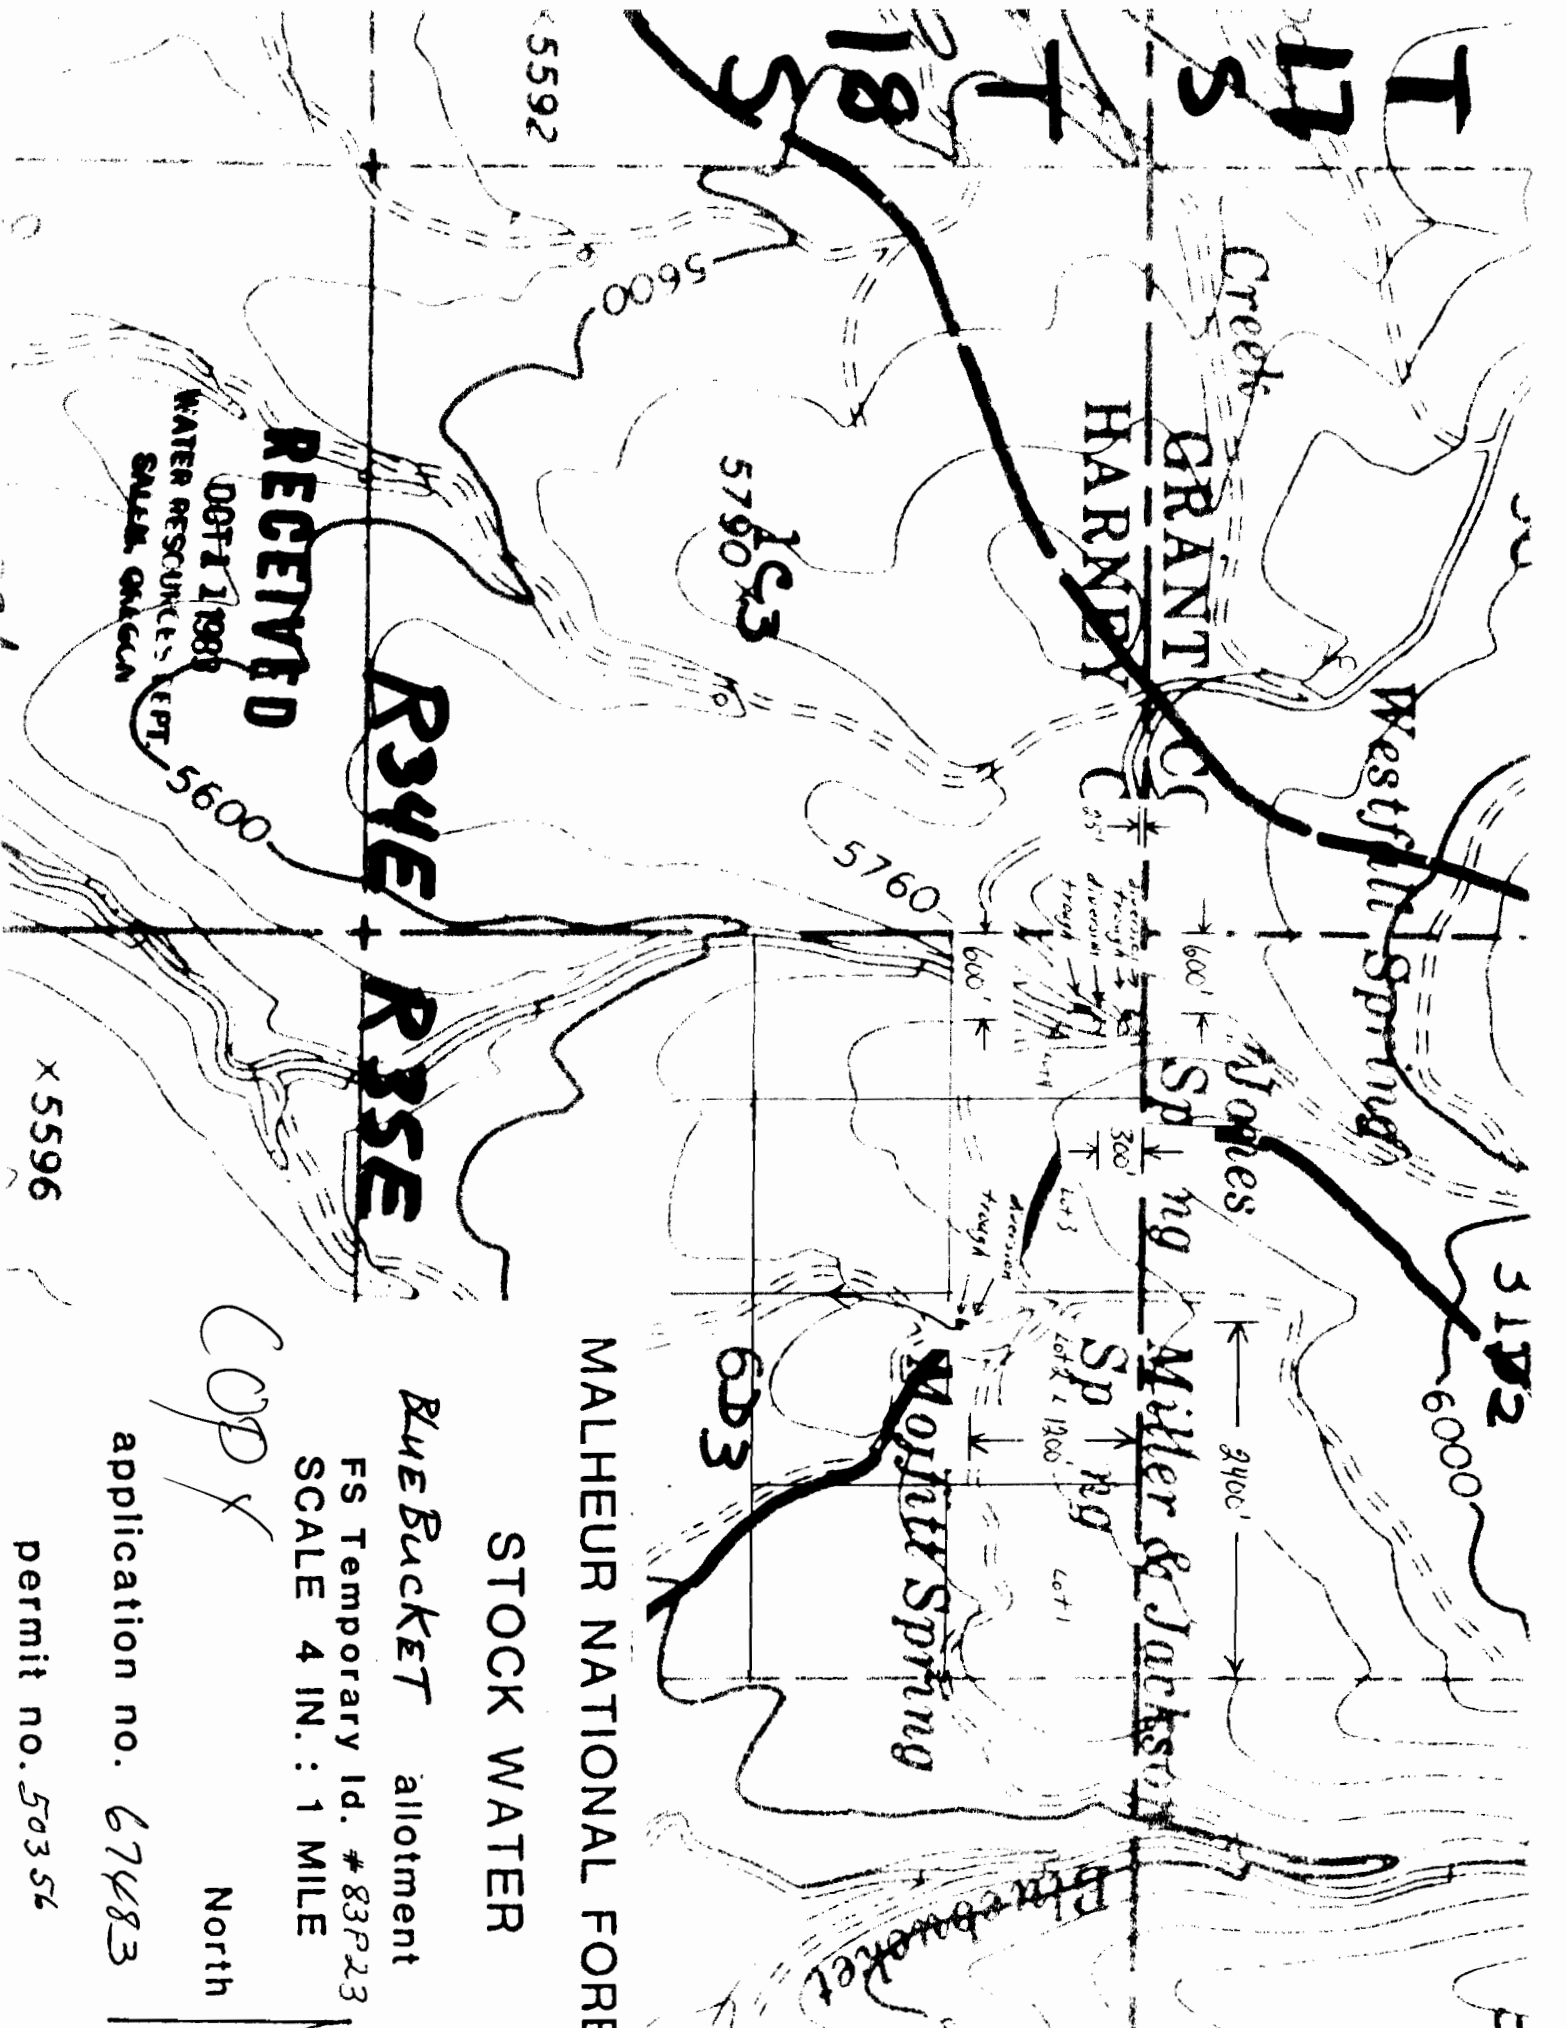

RECEIVED

DOT 11 1981

WATER RESOURCES DEPT.

R34E R35E

5596

MALHEUR NATIONAL FOREST

STOCK WATER

Blue Bucket allotment

FS Temporary Id. # 83P23

SCALE 4 IN. : 1 MILE

North

COP X

application no. 67483

permit no. 50356