

R31E

R-10840

MALHEUR NATIONAL FOREST

STOCK WATER (SLIQ)

Slide Creek allotment

FS Temp. ID# 83L10

SCALE 4 IN. : 1 MILE

North




application no. R-66815

permit no. R10840

4800

T9S  
T10S

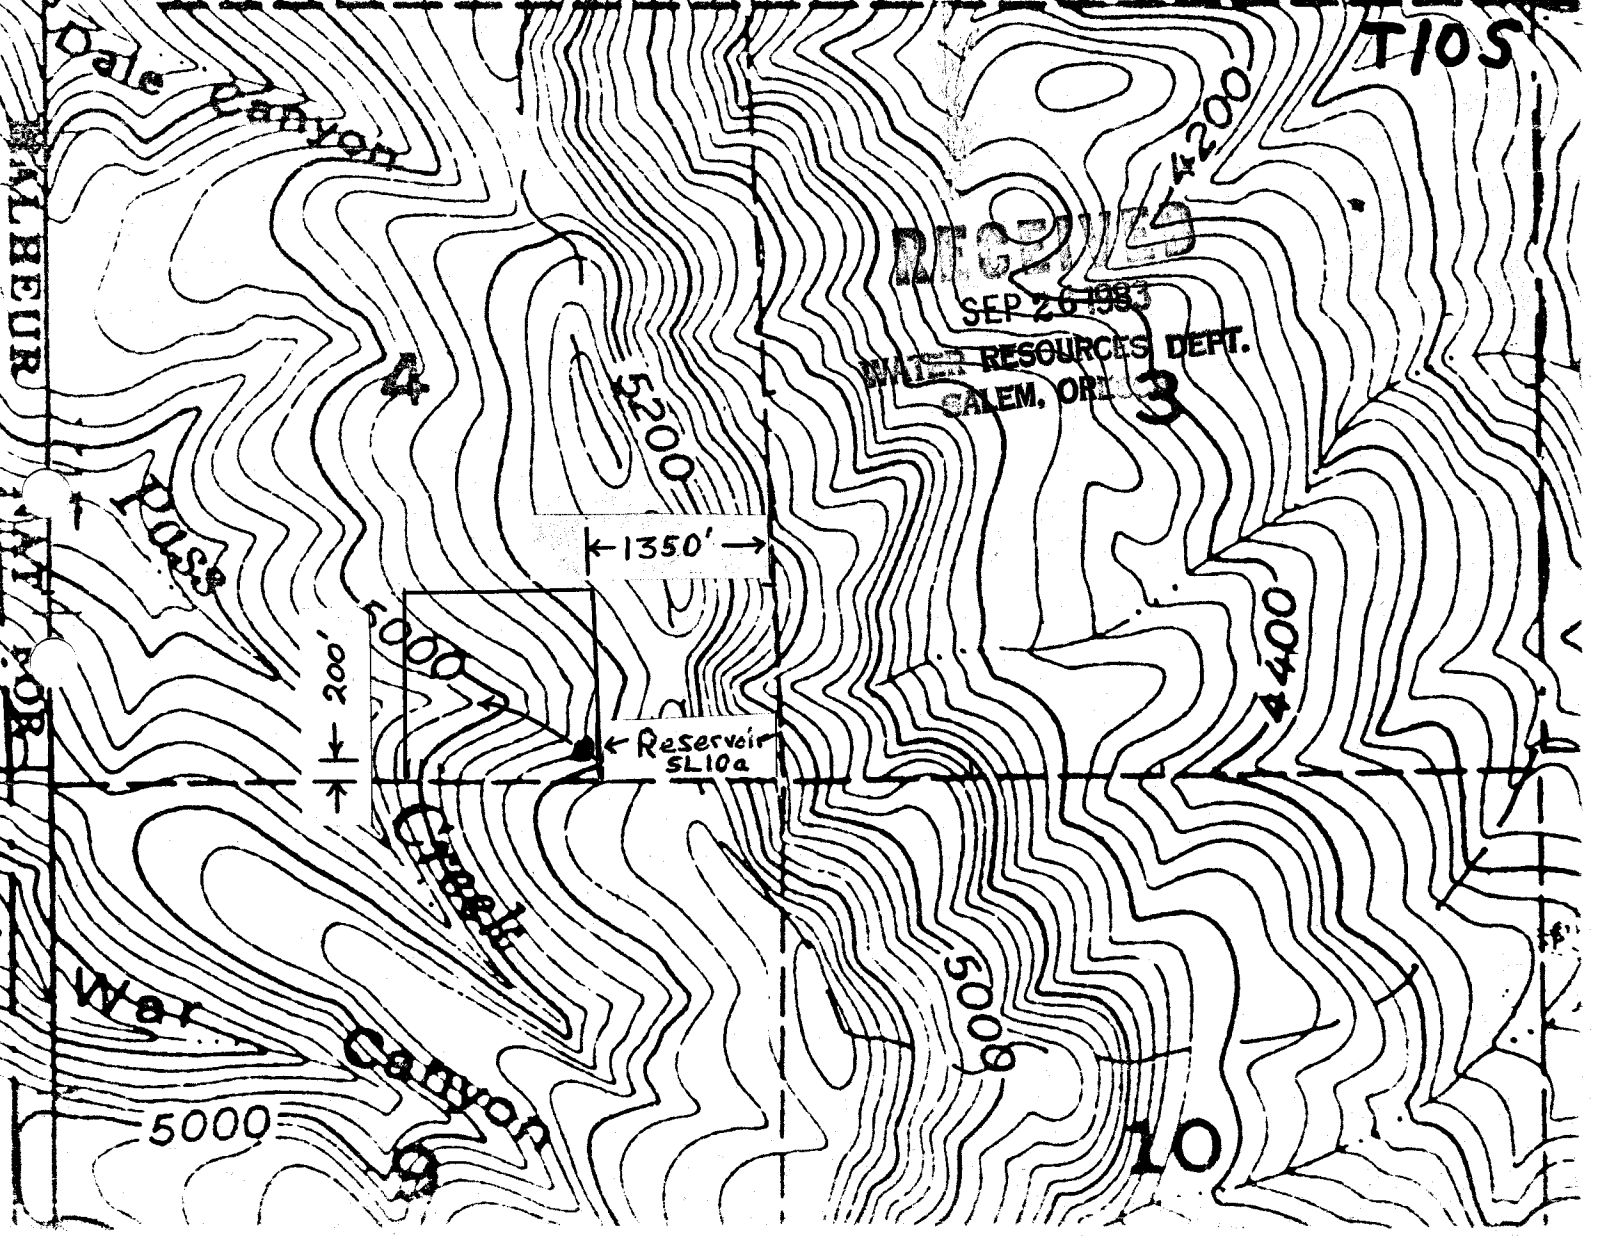

SEP 26 1983  
WATER RESOURCES DEPT.  
SALEM, ORE

← 1350' →

← 200' →

← Reservoir SL10a

5000

5000

4400

10