


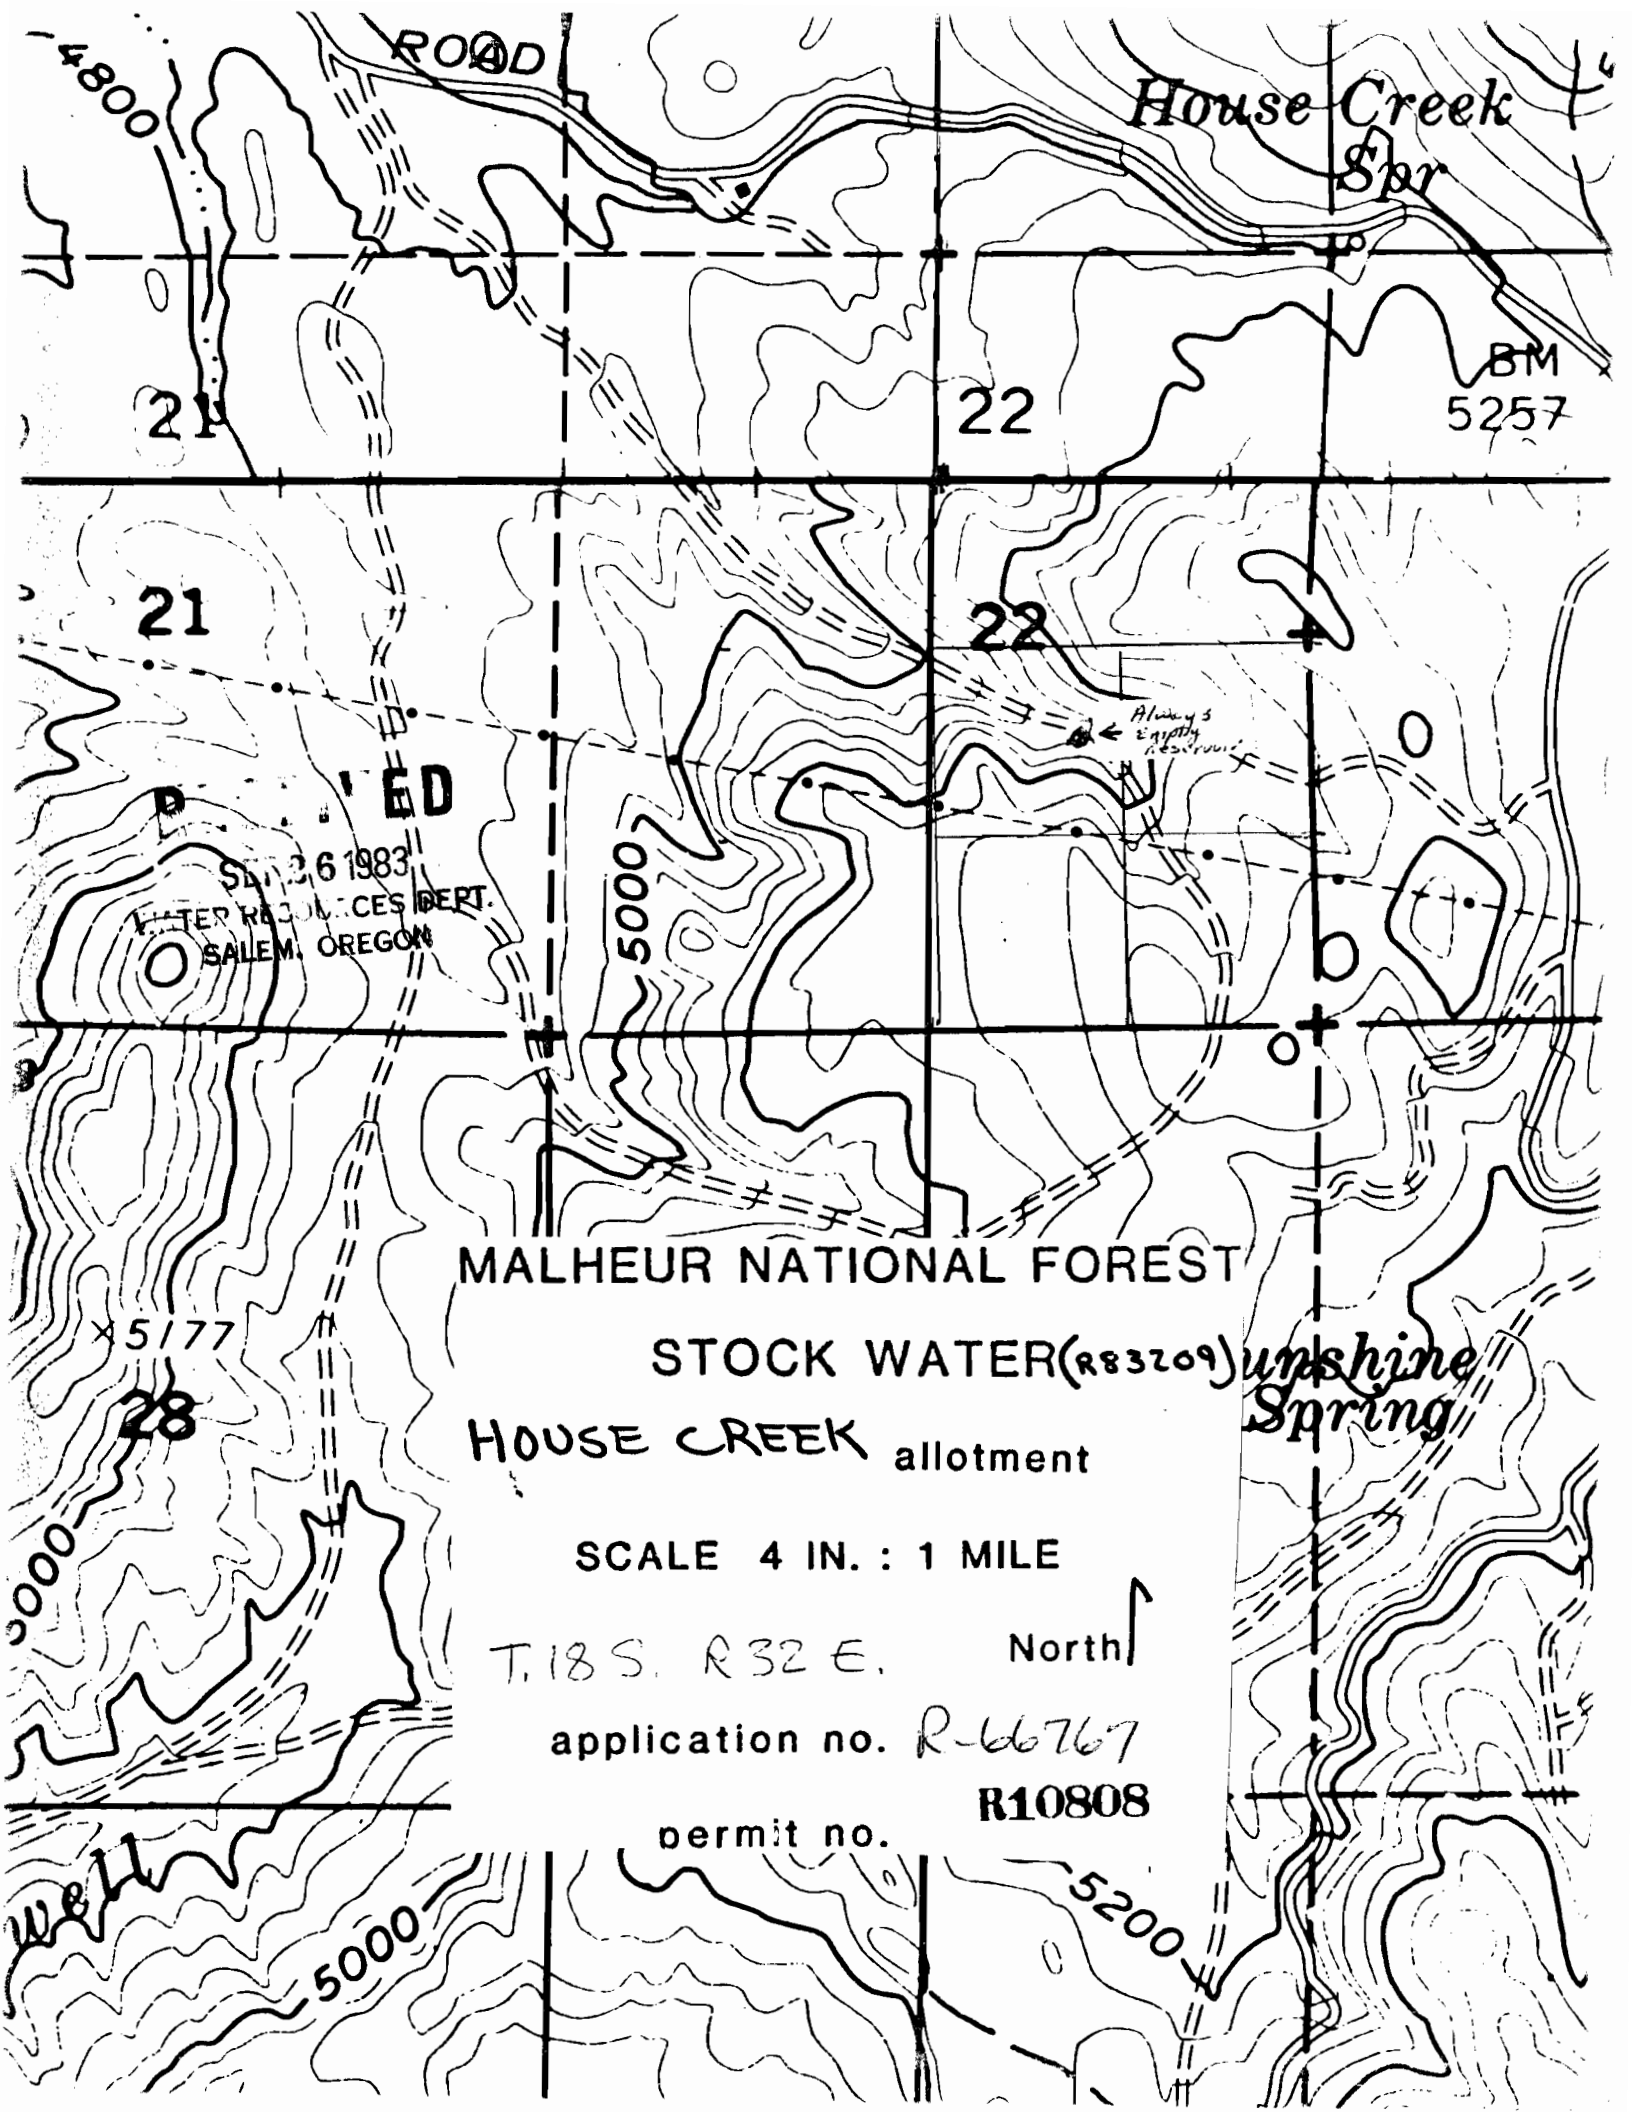

ROAD

House Creek
Spr

BM
5257

21

22

21

22

SEP 26 1983

WATER RESOURCES DEPT.
SALEM, OREGON

5000

Always Empty
Reservoir

MALHEUR NATIONAL FOREST

STOCK WATER (R83209)

Sunshine
Spring

HOUSE CREEK allotment

SCALE 4 IN. : 1 MILE

T. 18 S. R. 32 E.

North

application no. R-66767

R10808

permit no.

5000

5200