


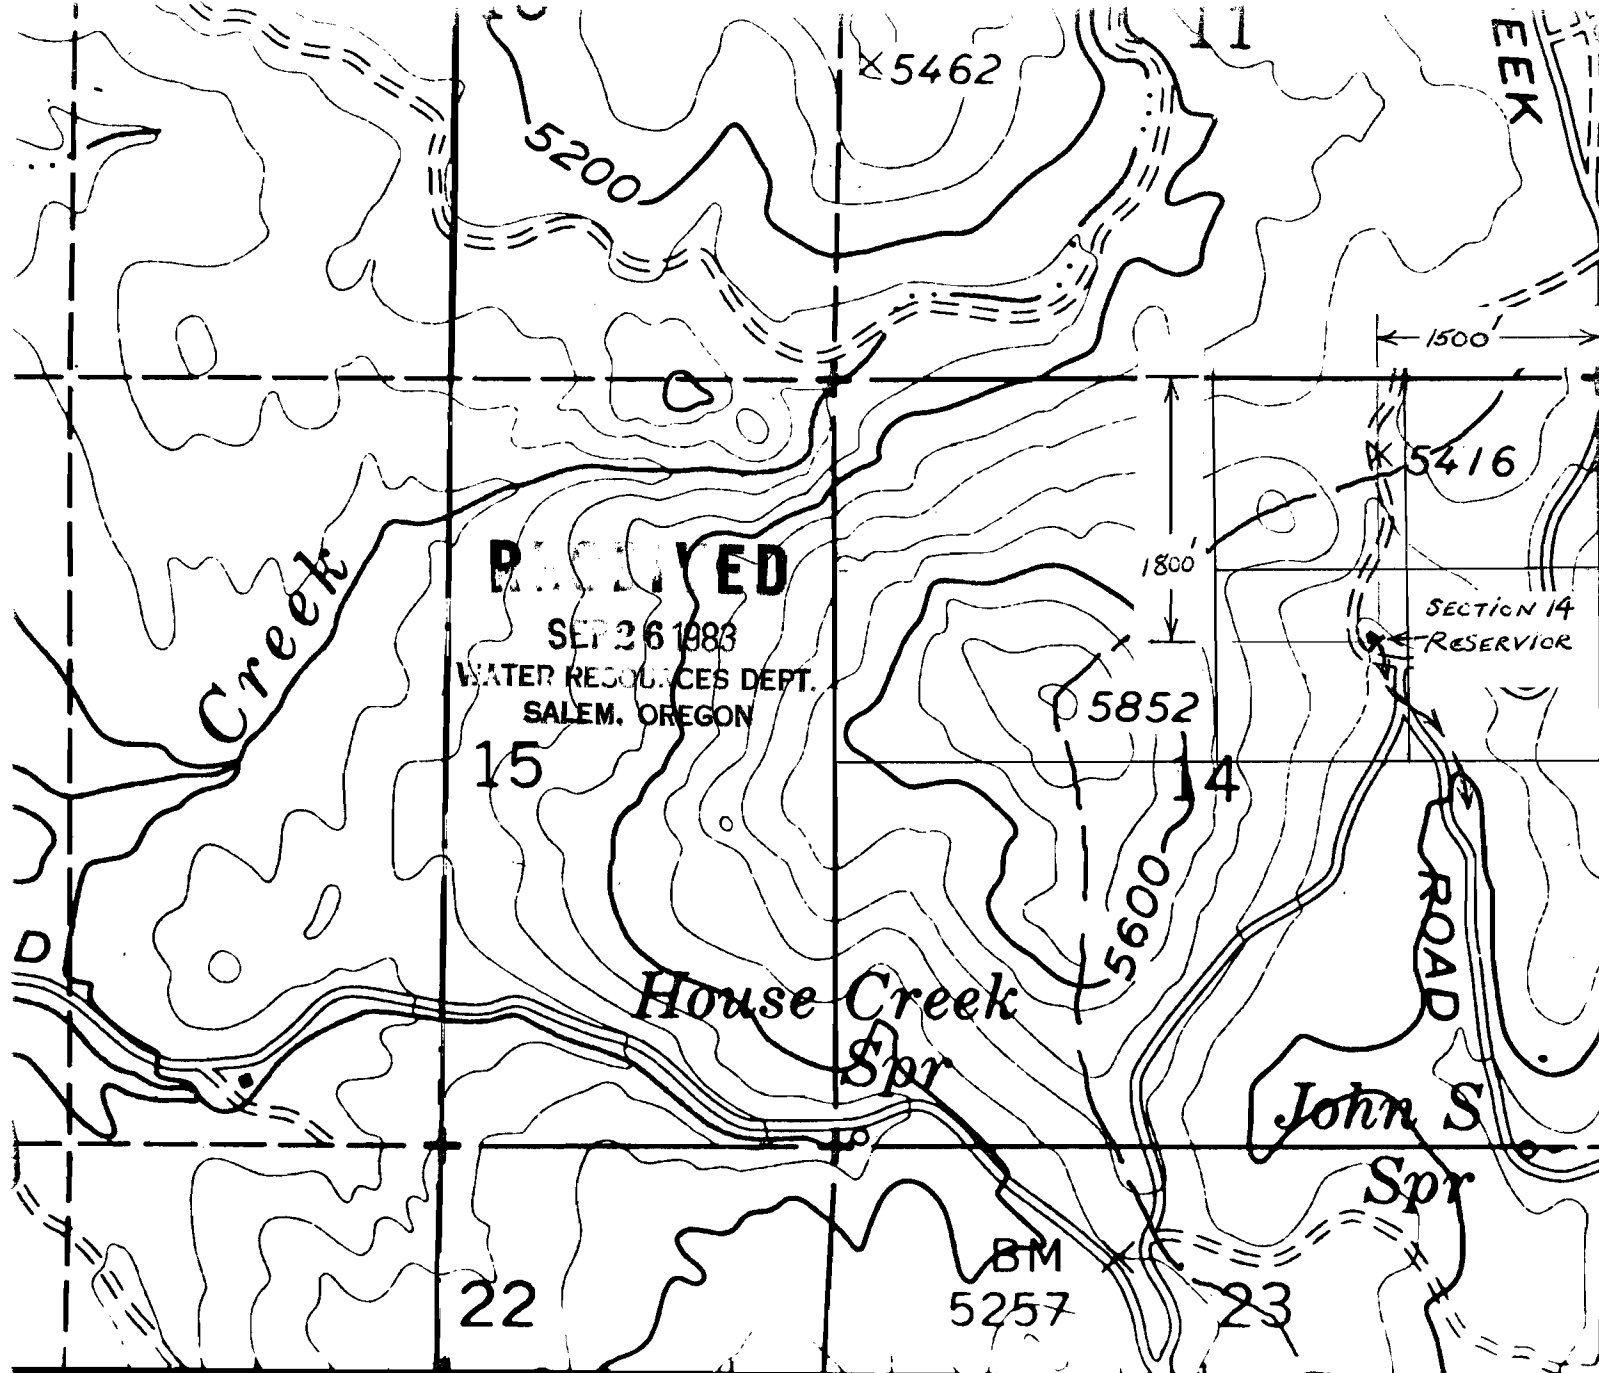

MALHEUR NATIONAL FOREST

STOCK WATER (R13211)
HOUSE CREEK allotment

SCALE 4 IN. : 1 MILE

T. 18 S. R. 32 E.

North ↑

application no. R-66766

permit no. R10807

23 Rock Springs

