


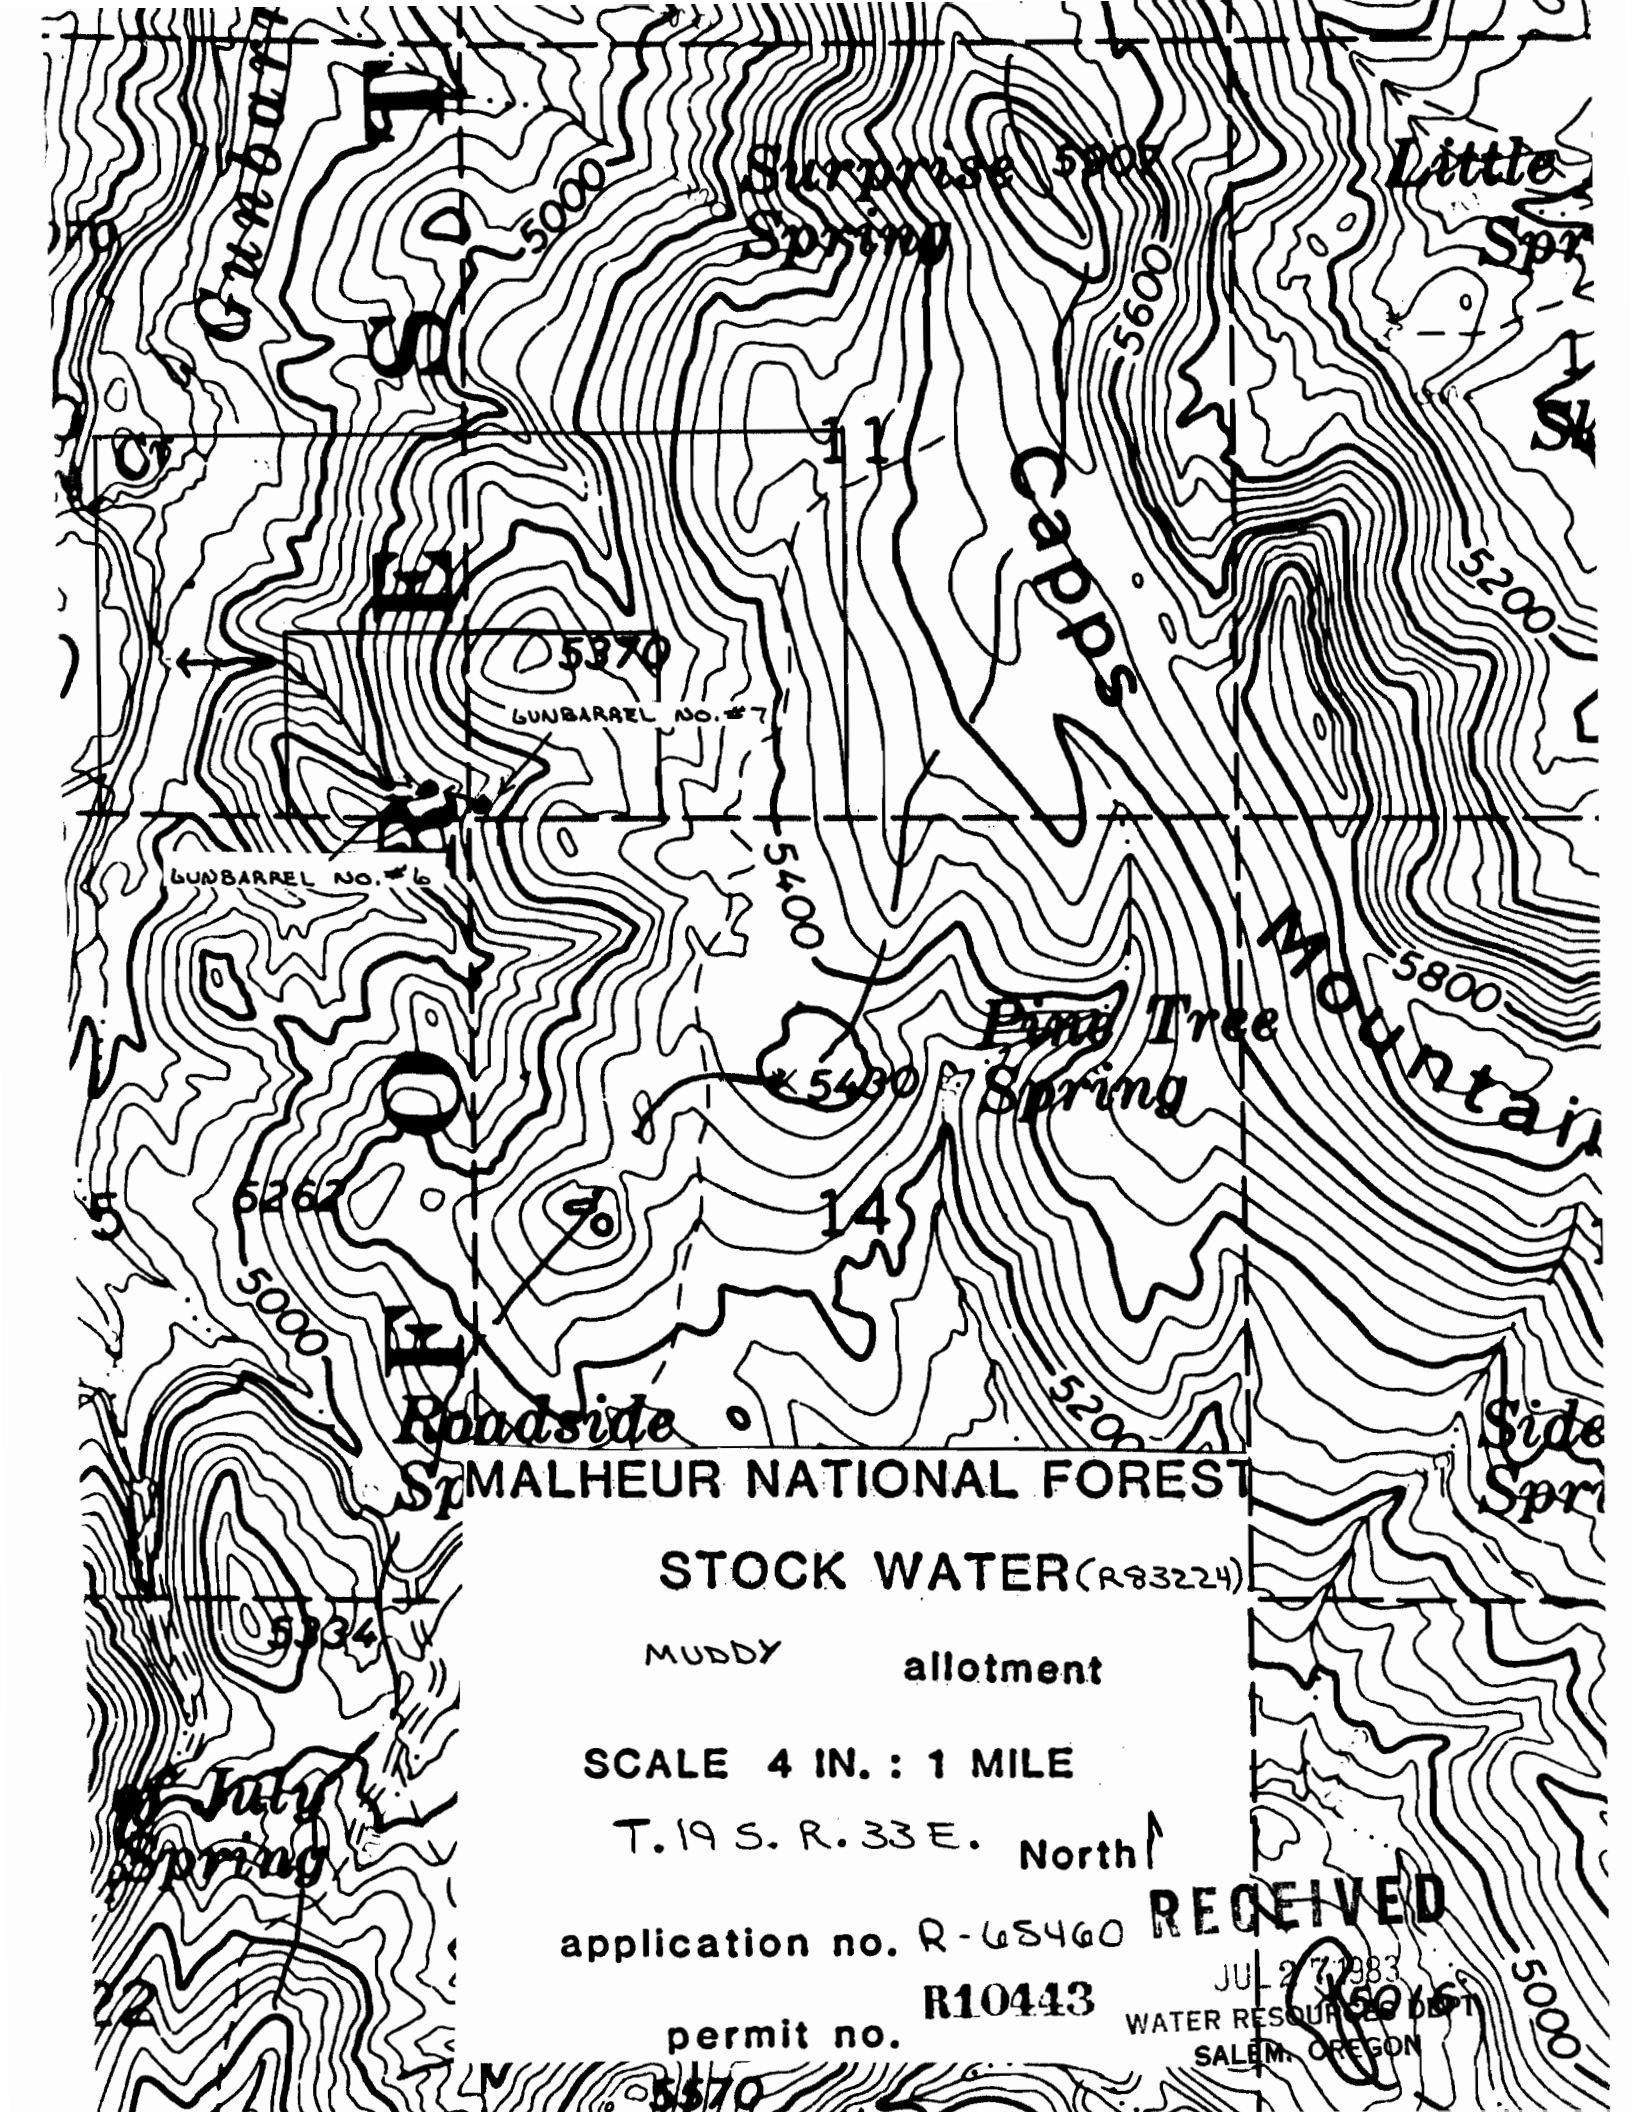

Surprise Spring 5900

Little Spr

Capps

Mountain

Pine Tree Spring

Roadside

Side Spr

SMALHEUR NATIONAL FOREST

STOCK WATER (R83224)

MUDDY allotment

SCALE 4 IN. : 1 MILE

T. 19 S. R. 33 E. North

application no. R-65460

RECEIVED

permit no. R10443

JUL 27 1983
WATER RESOURCES DEPT
SALEM, OREGON

July Spring

5570

5000