


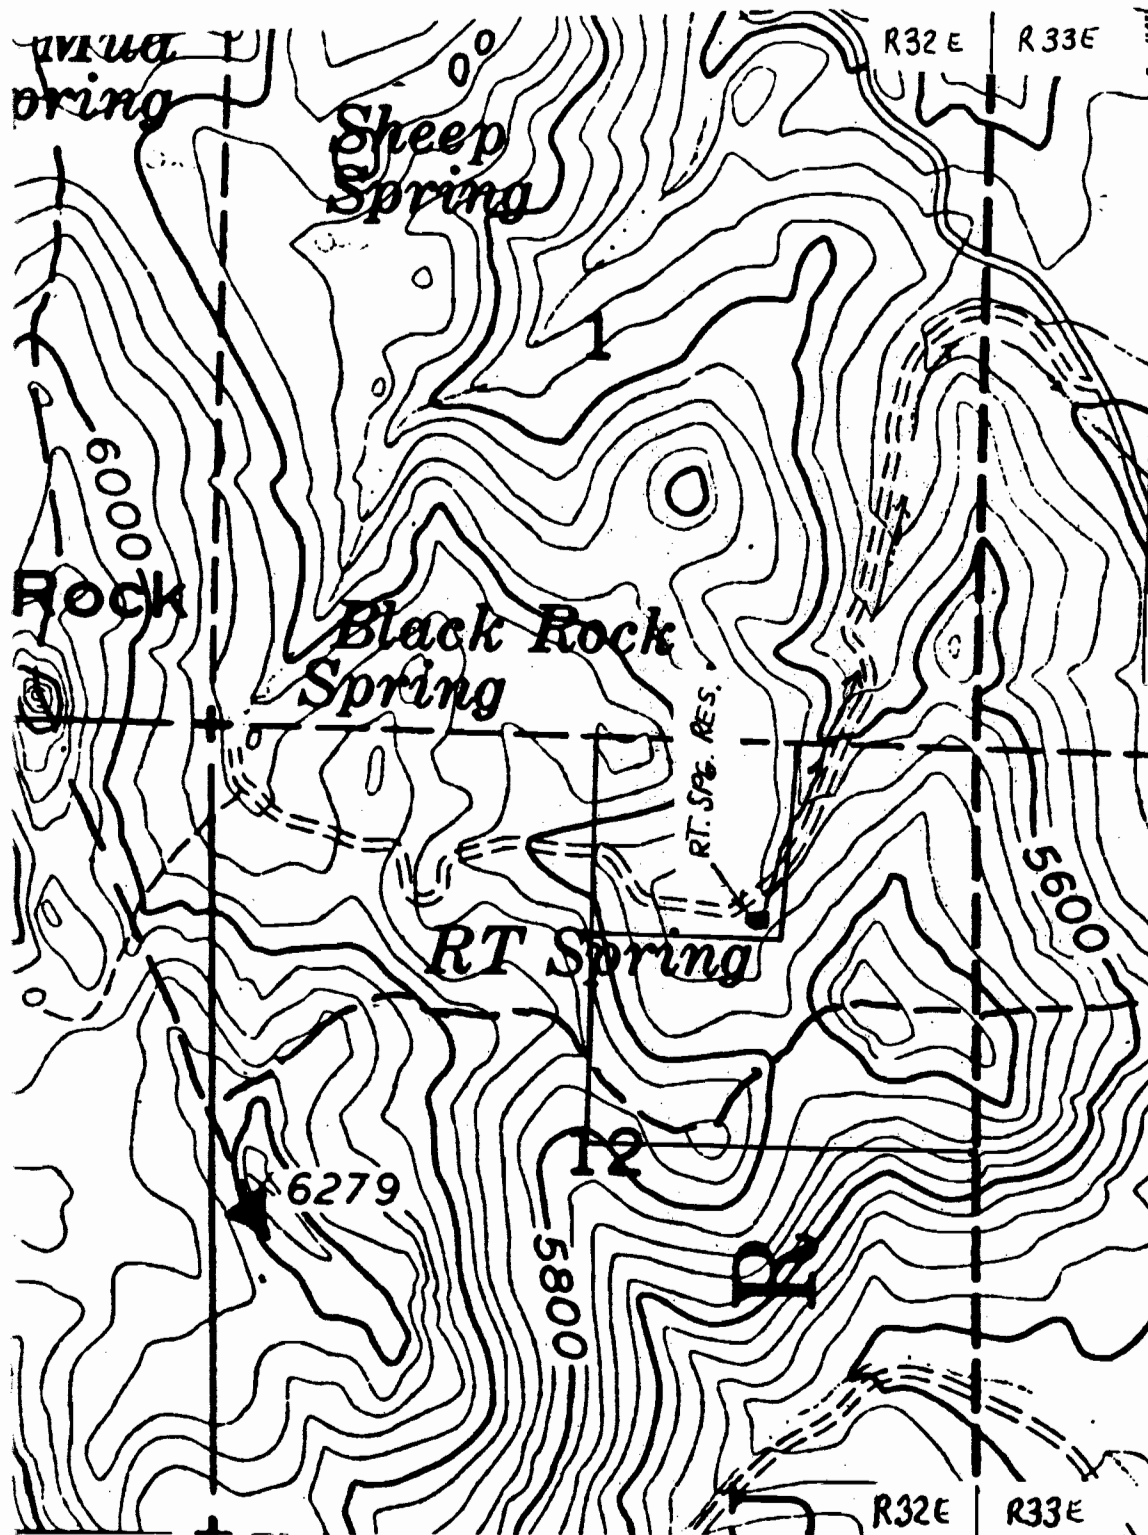

MALHEUR NATIONAL FOREST

STOCK WATER (R83154)

ALKALI allotment

SCALE 4 IN. : 1 MILE

North

application no. R-65440

permit no. R10430

RECEIVED

JUL 27 1983
WATER RESOURCES DEPT.
SALEM, OREGON

Cabin

T. 20 S

TRAIL