


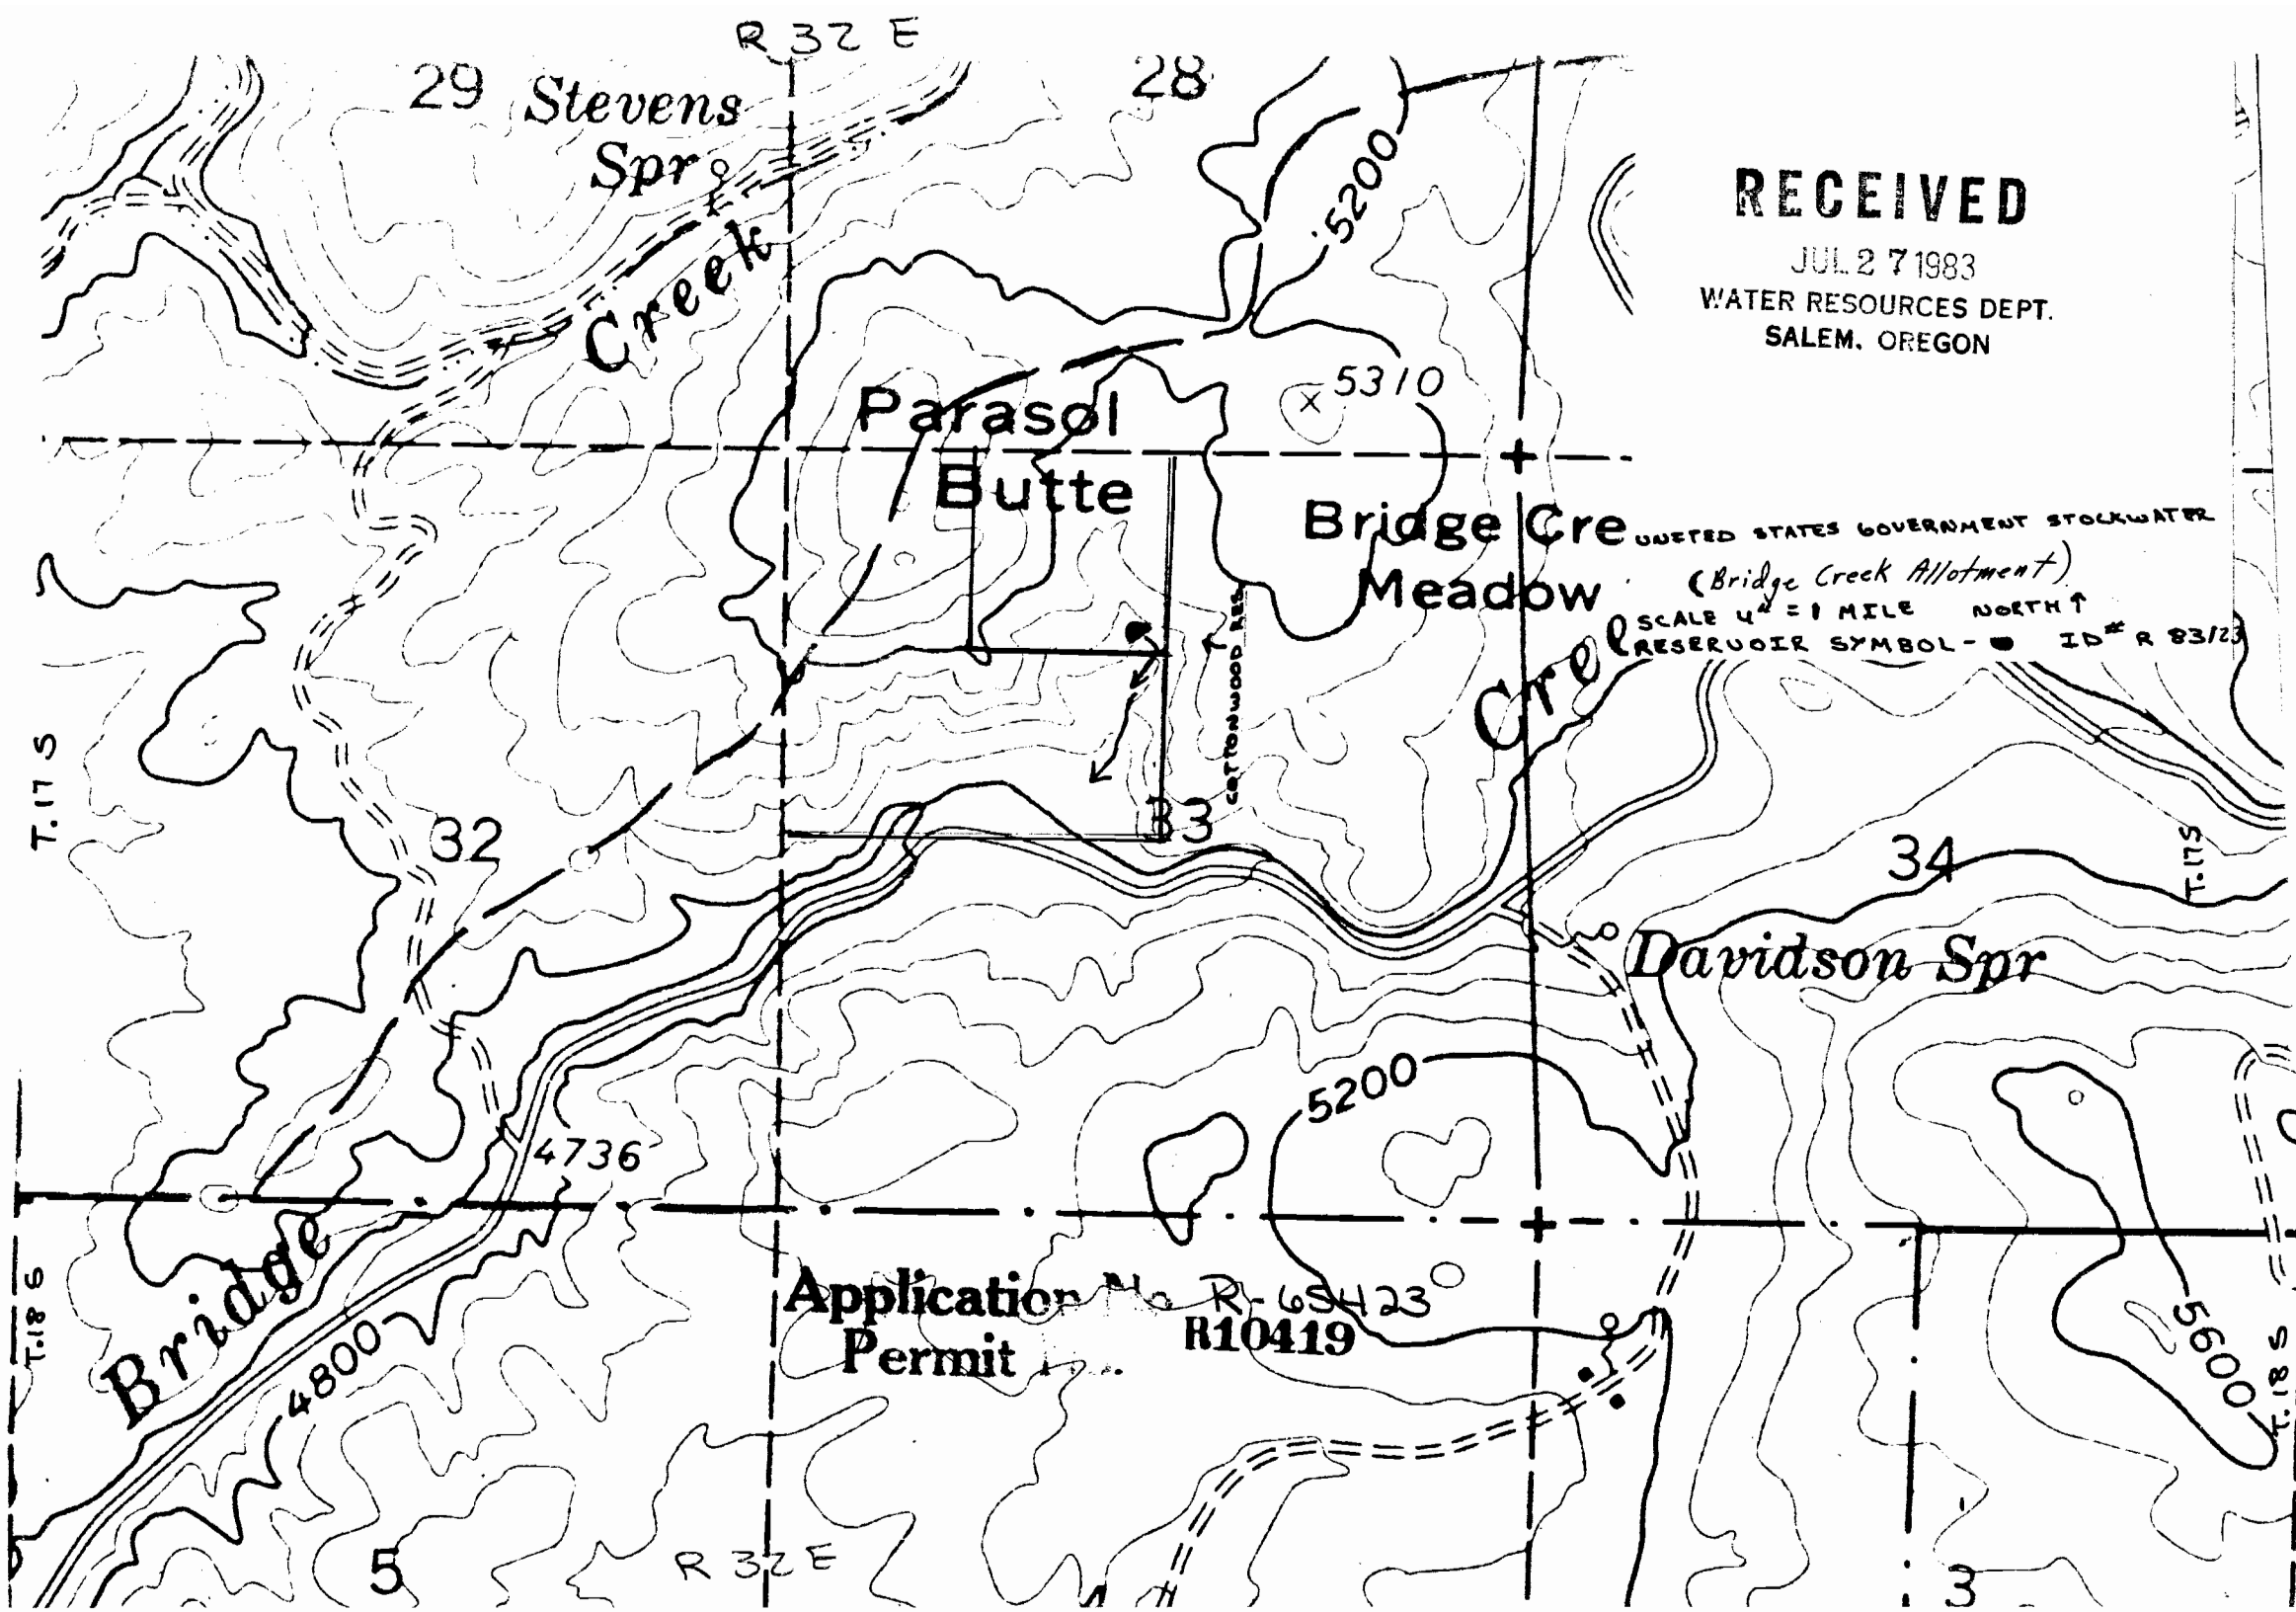

RECEIVED

JUL 27 1983
WATER RESOURCES DEPT.
SALEM, OREGON

UNITED STATES GOVERNMENT STOCKWATER
(Bridge Creek Allotment)
SCALE 1" = 1 MILE NORTH ↑
RESERVOIR SYMBOL - ● ID# R 83/23

Application No. R-65423
Permit R10419