


SECTION

11 - # 5494
Domingo Road Res

1 SWSE

TOWNSHIP 39 S, RANGE 33 E, W. M.

North

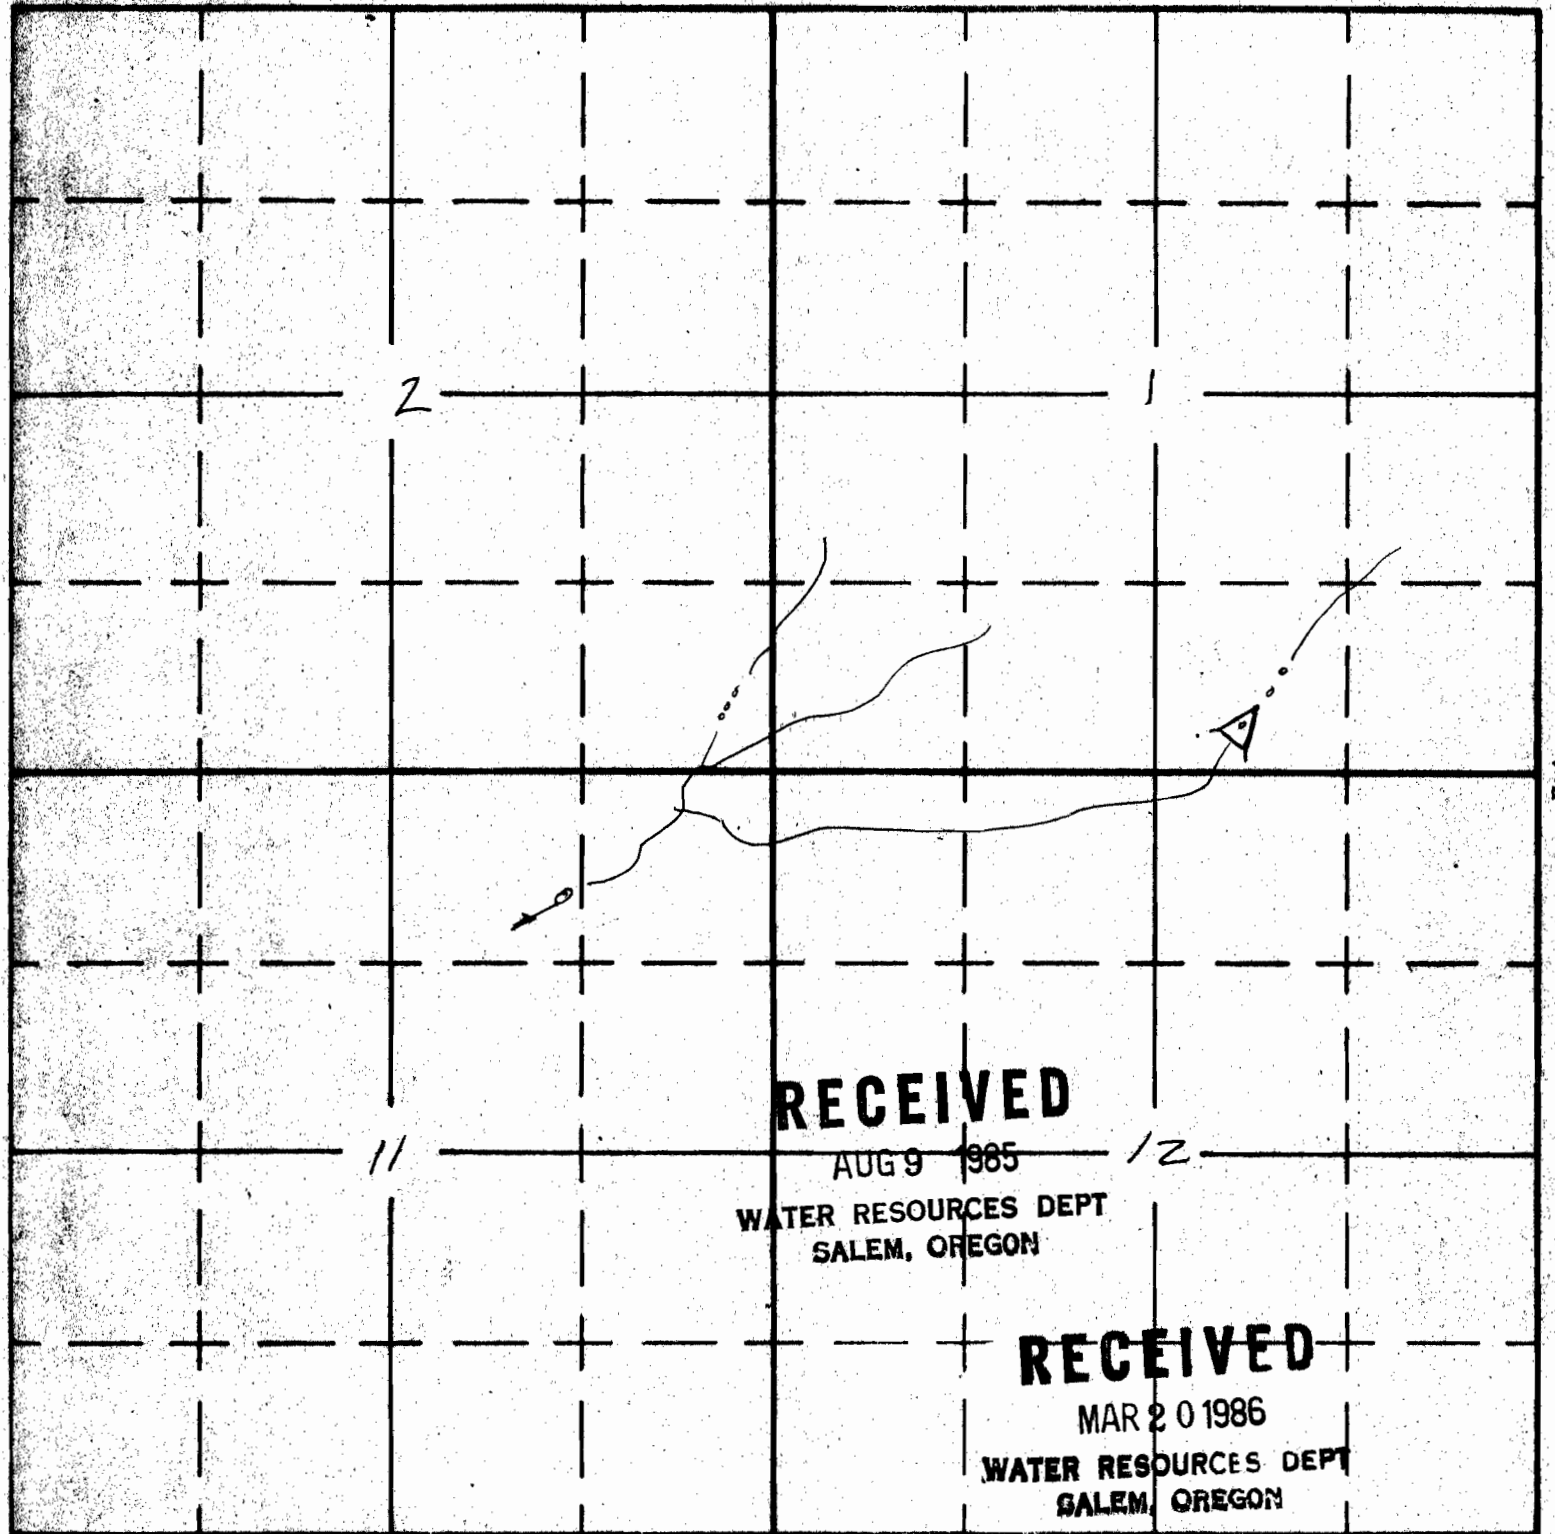

South

APPLICATION NO R-68506

PERMIT NQ R11030