



RED TOP SPRING
T.13S, R.14E., Sec. 20
SW of SW.

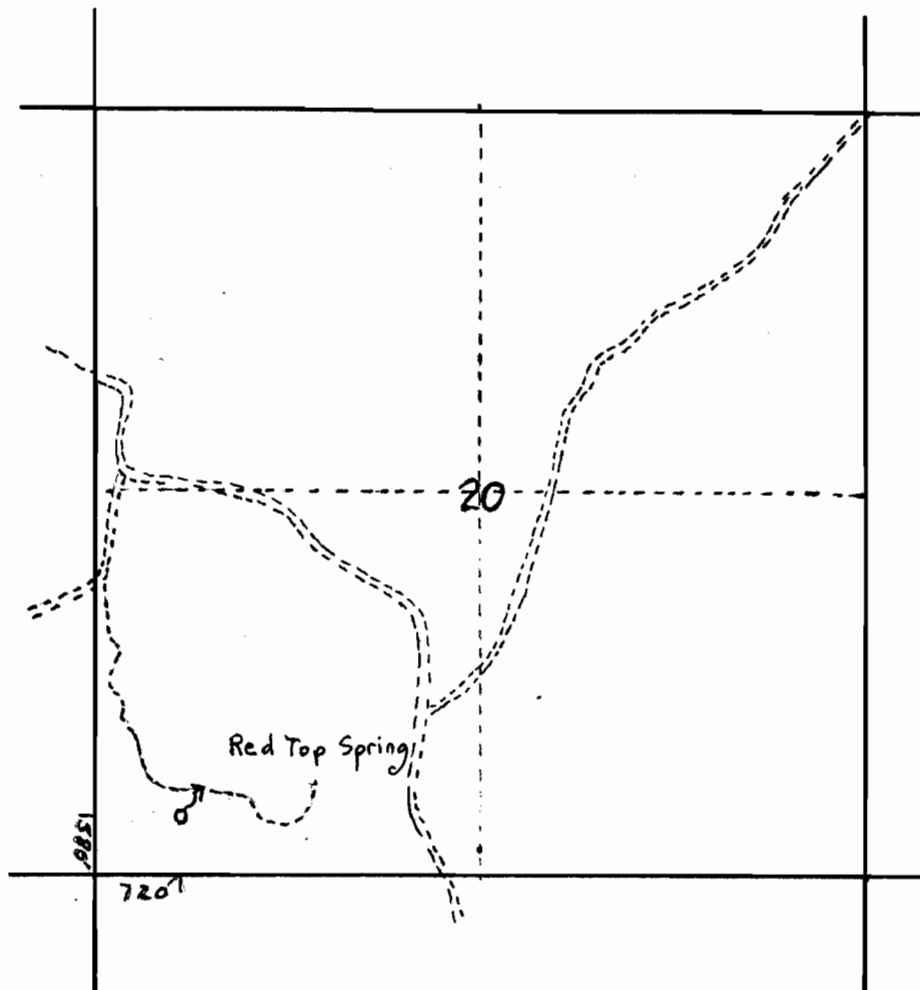

RECEIVED
SEP 19 1983
WATER RESOURCES DEPT.
SALEM, OREGON

SCALE
4" = 1 MILE

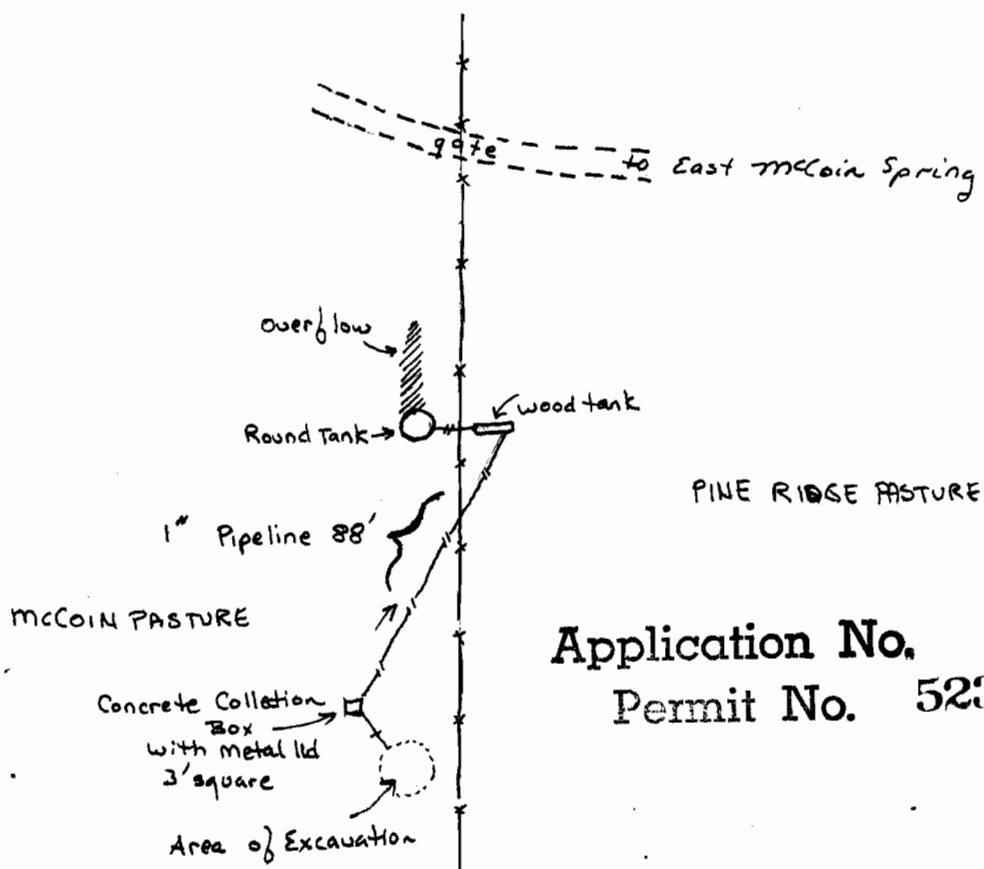

Application No. 66405
Permit No. 52368