

SECTION

20


SE NE

TOWNSHIP 40S, RANGE 37E, W. M.

11-4753

OLD RED MT.
SPRING

North

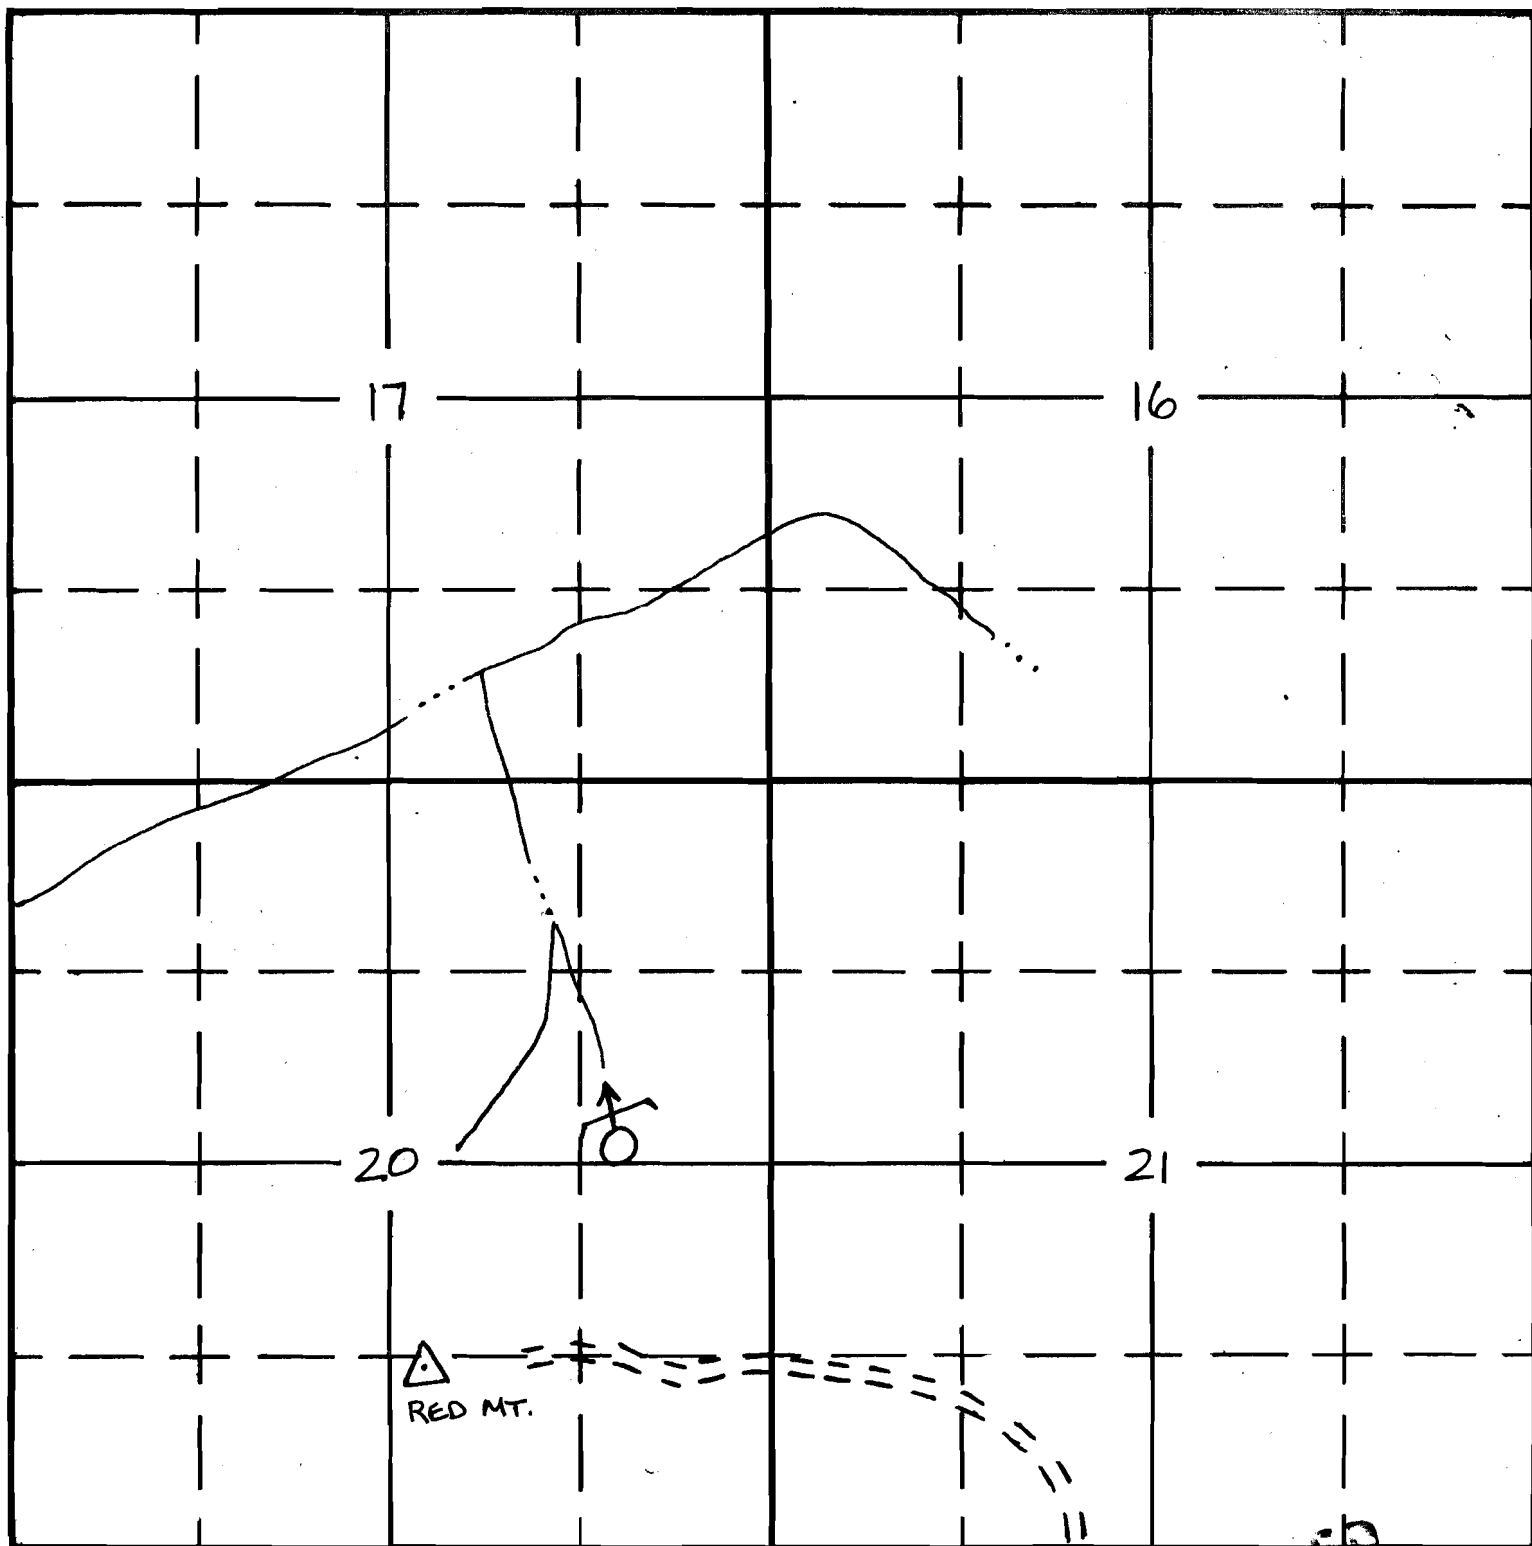

South

Application No. 66532
Permit No. 50551

SL. 11983
CES DEPT.
SALEM, OREGON