

SECTION


17

SE NW

Amos Spring
11-5106

TOWNSHIP 40 S, RANGE 38 E, W. M.

North

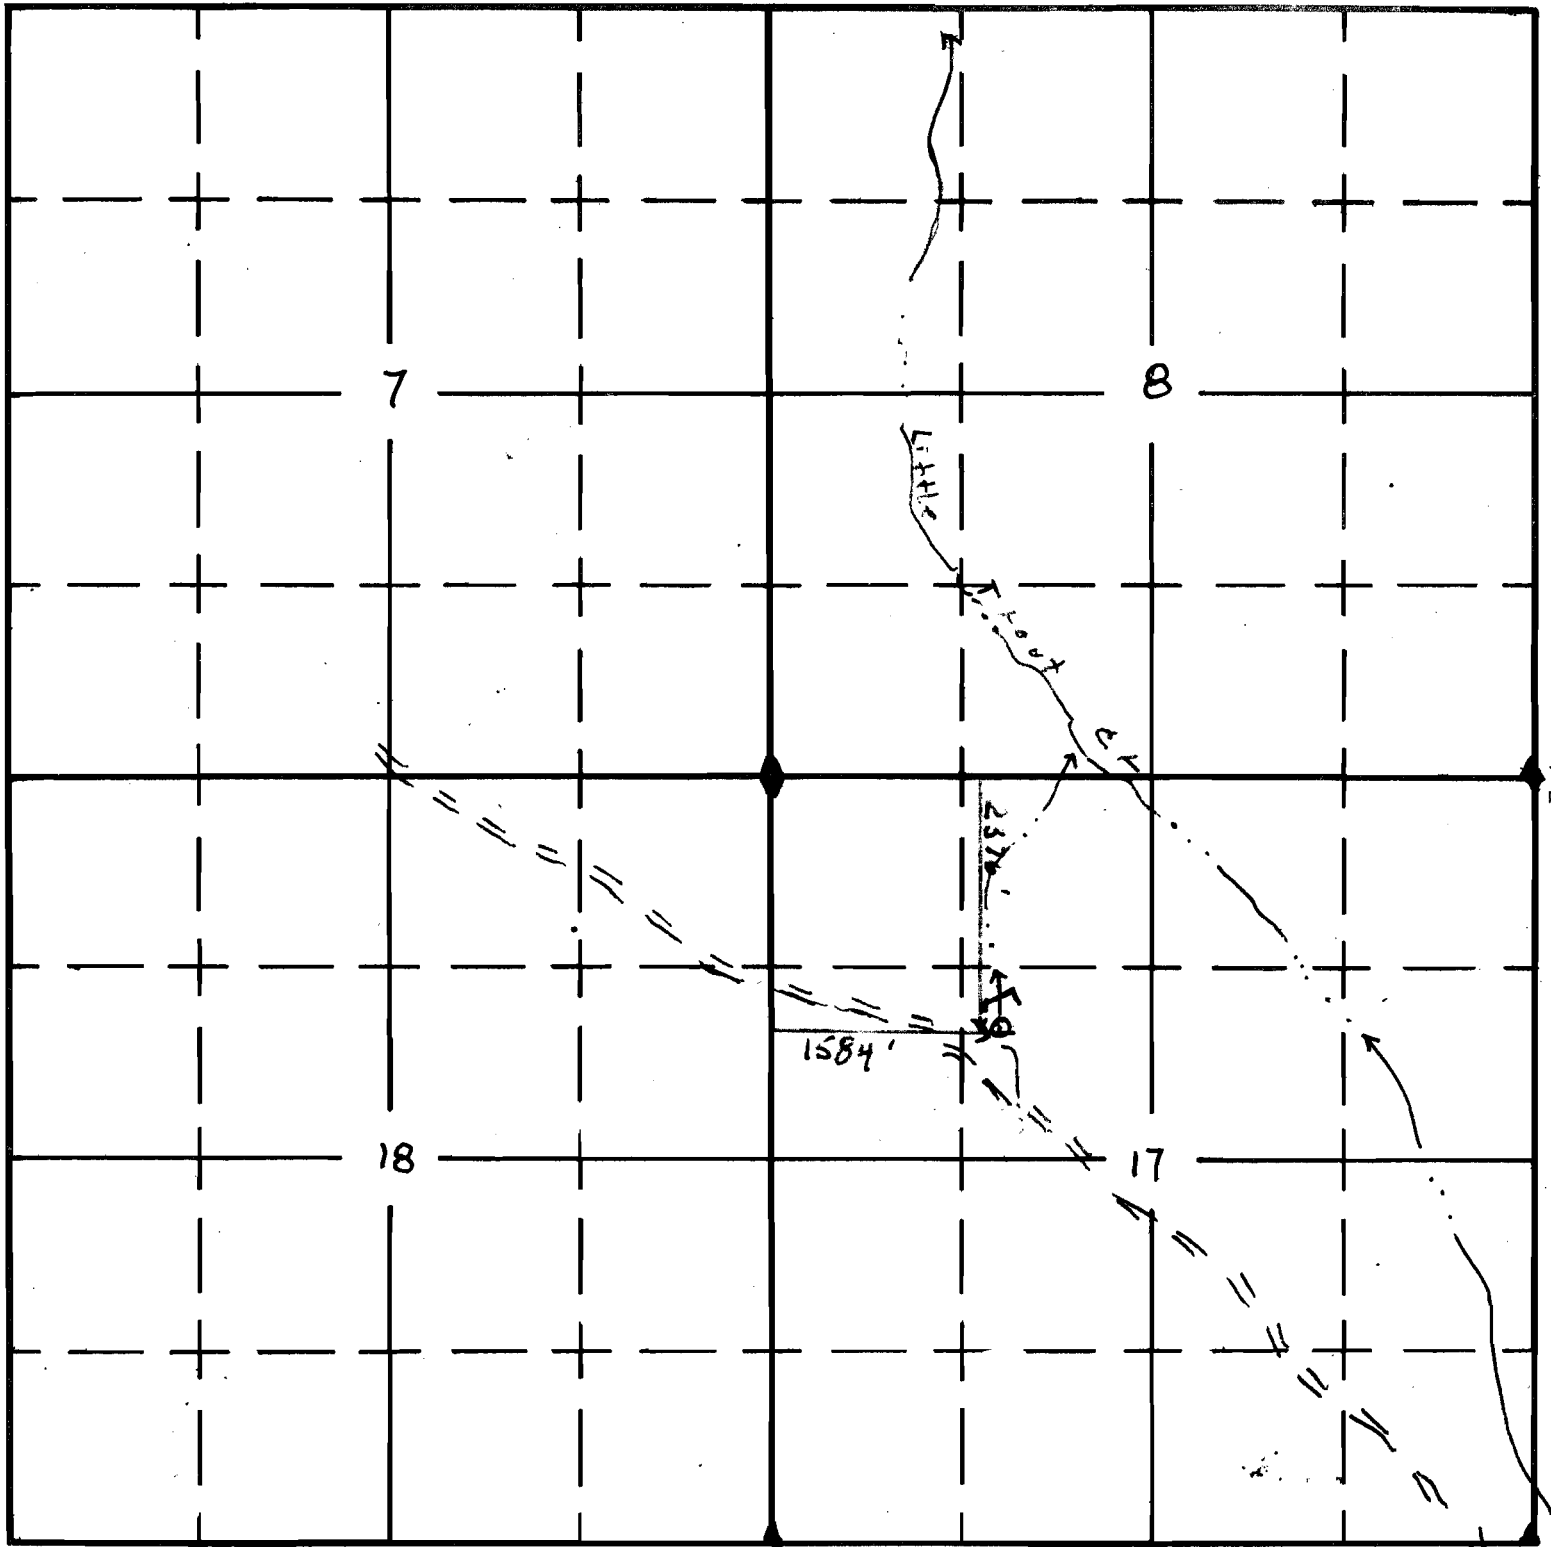

South

Application No. 66555
Permit No. 50786

SL. 11983
SALEM, OREGON