


SECTION

2

SE SE

TOWNSHIP 40 S, RANGE 36 E, W. M.

Antelope Spring
11-5014

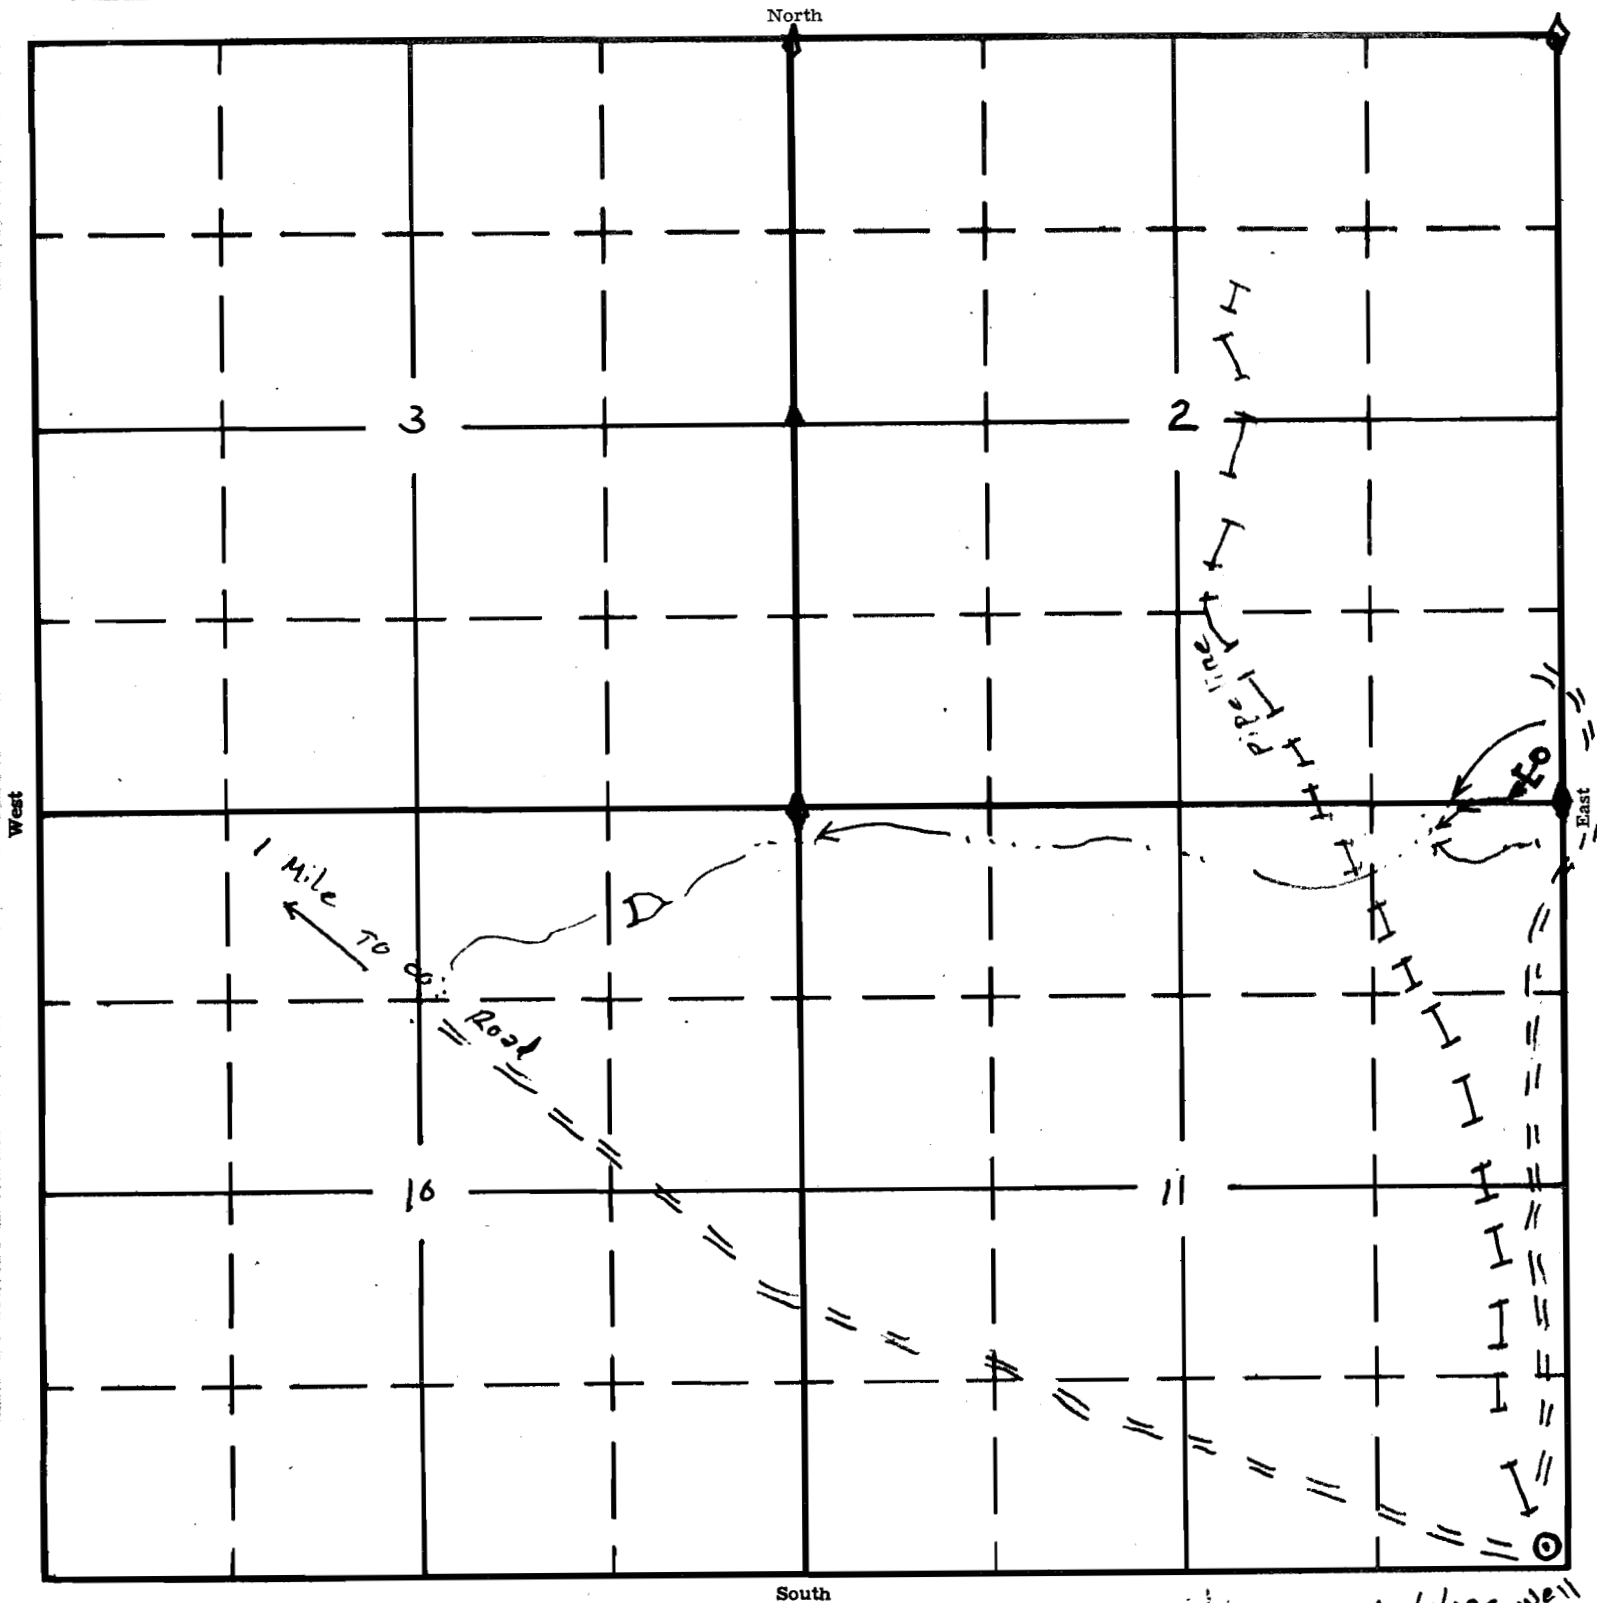

Application No. 66556
Permit No. 507856

SL. 11983
N. H. CES DEPT.
SALEM, OREGON