


UNITED STATES
DEPARTMENT OF THE INTERIOR
BUREAU OF LAND MANAGEMENT

SECTION 19

Oregon State Water Filings

TOWNSHIP 39S, RANGE 38E, W. M.

North

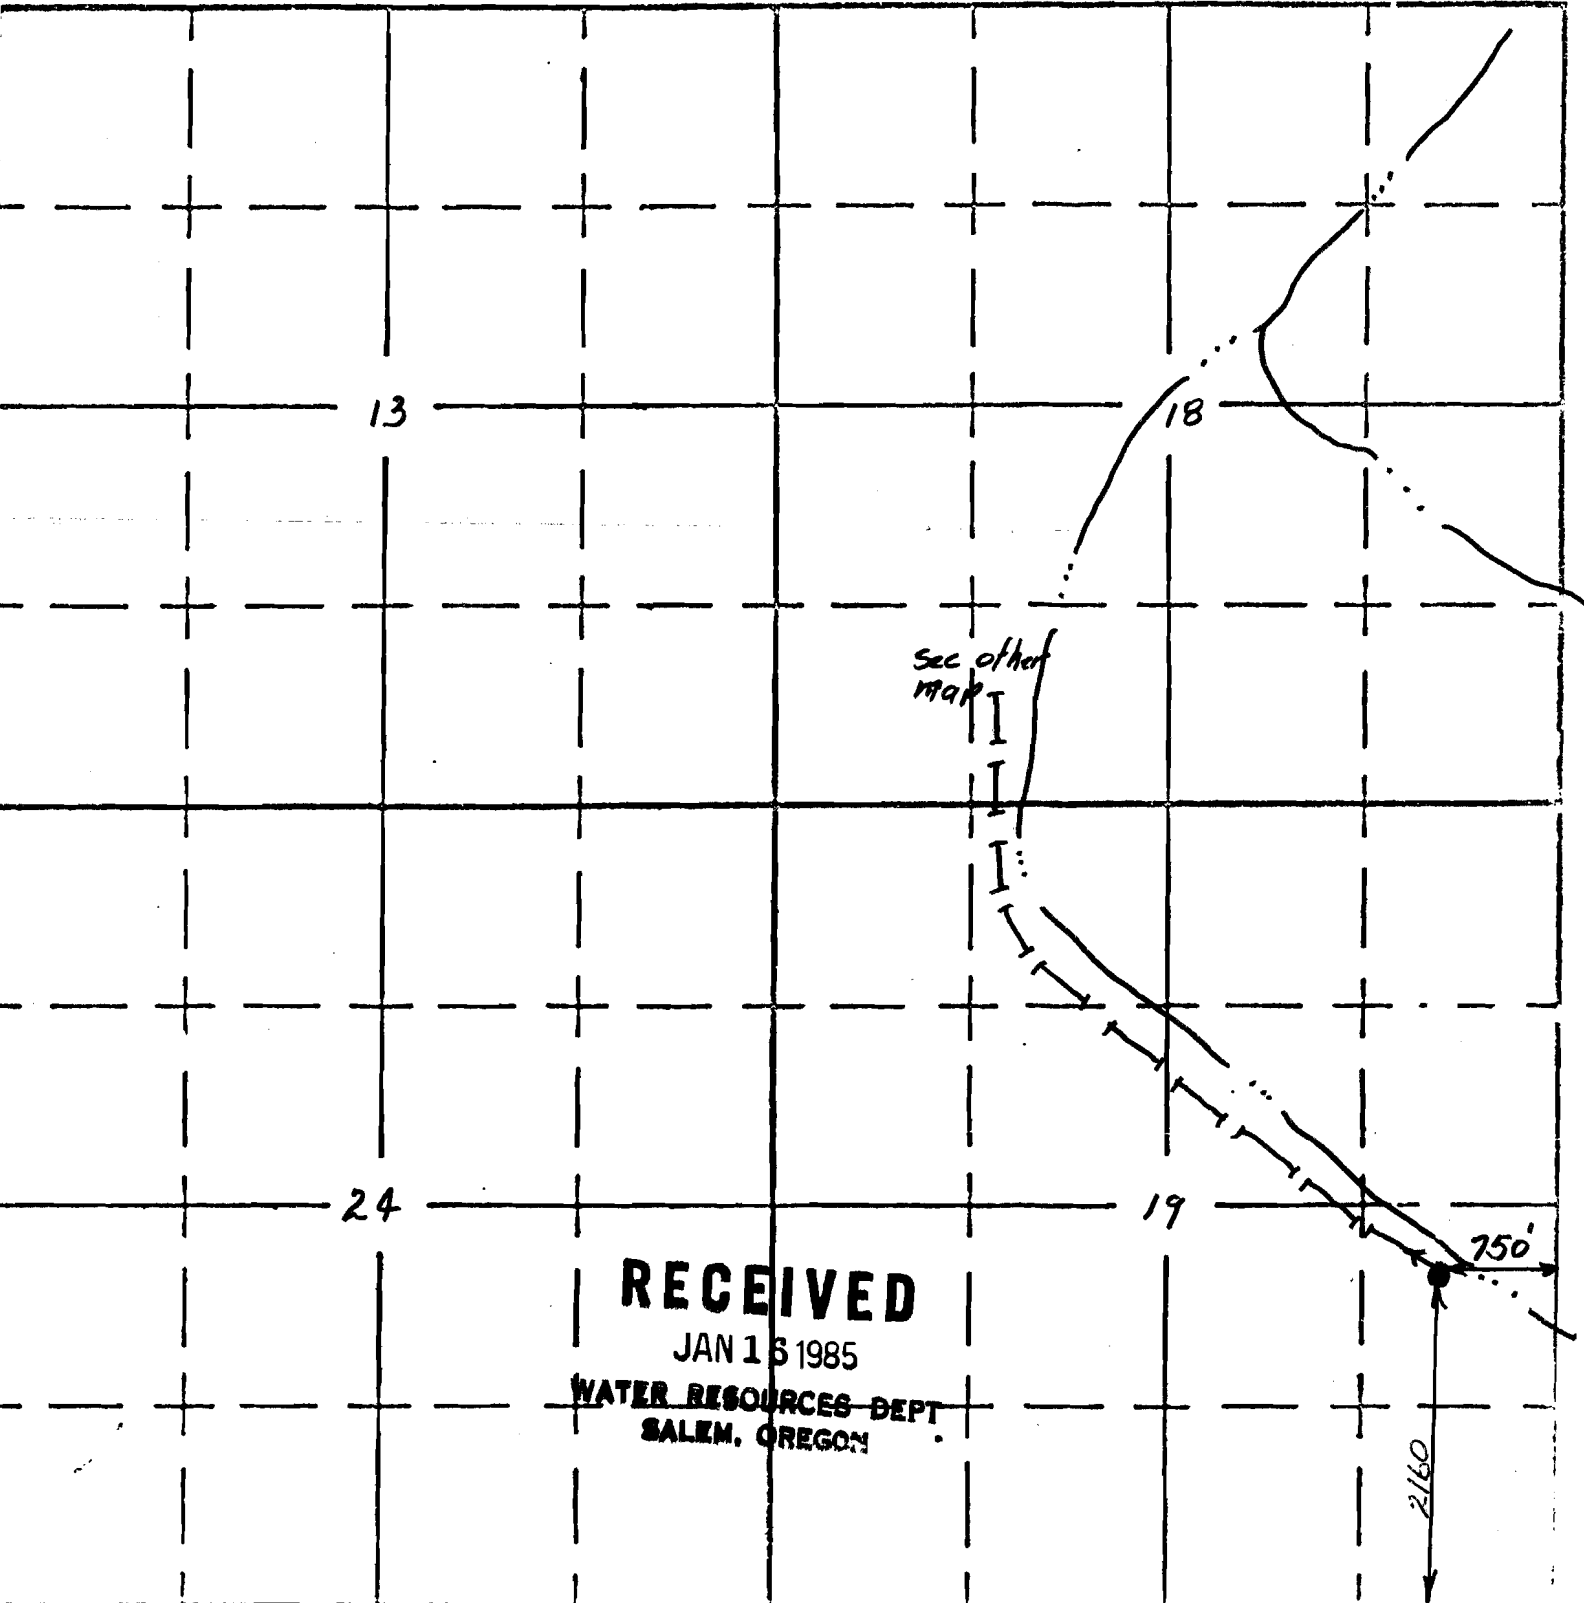

South

50788

APPLICATION No. 66559