


SECTION

18
NW SE

11-4039

Miners Spring

TOWNSHIP 37S, RANGE 33E, W. M.

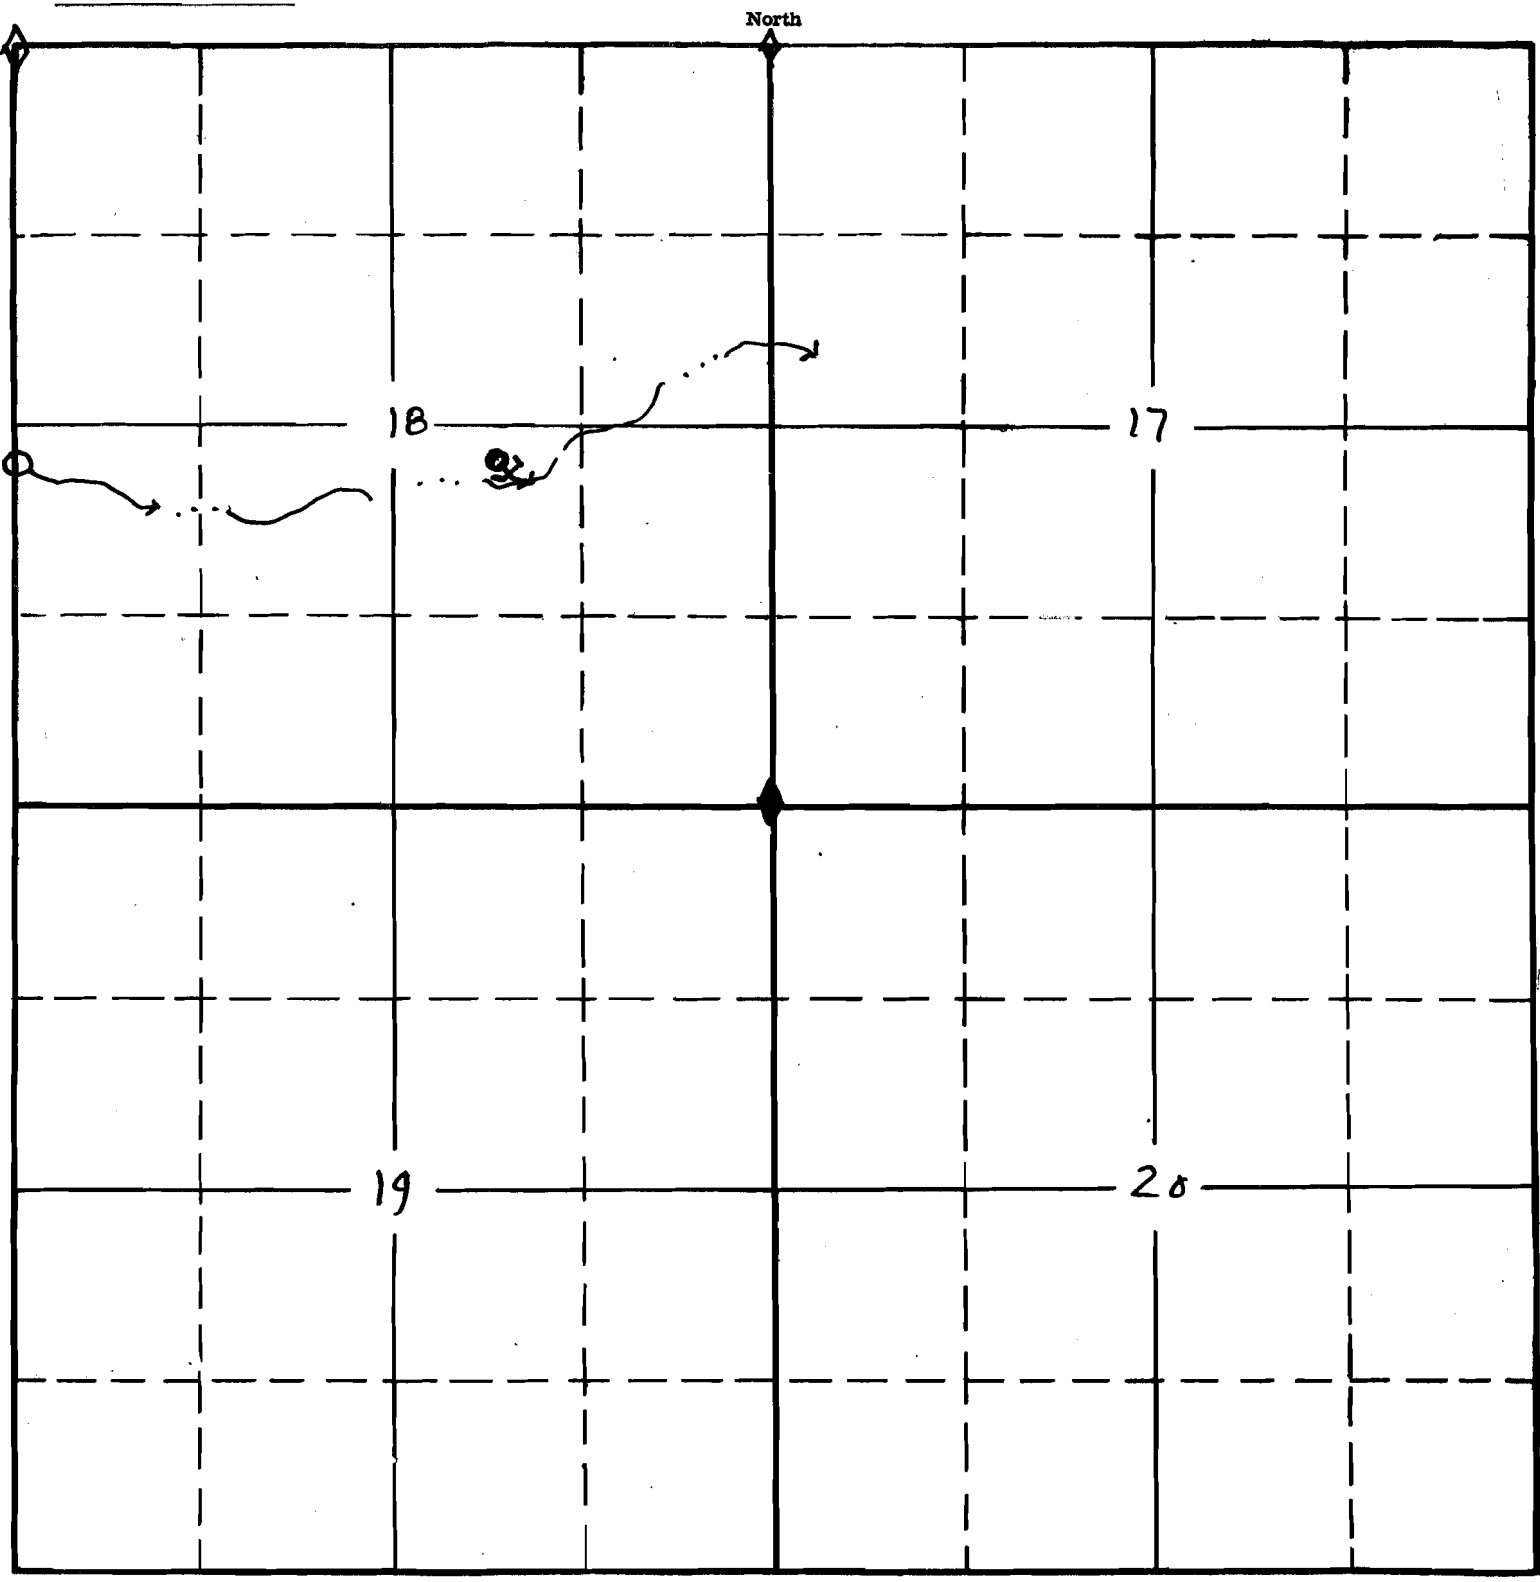

Application No. 66566
Permit No. 50199

RECEIVED

APPLICATION No.
PERMIT No.

SEP 21 1983
WATER RESOURCES DEPT.
SALEM, OREGON