

SECTION

12


NE NE

11-4660

scotts Butte springs

TOWNSHIP 41S, RANGE 37E, W. M.

North

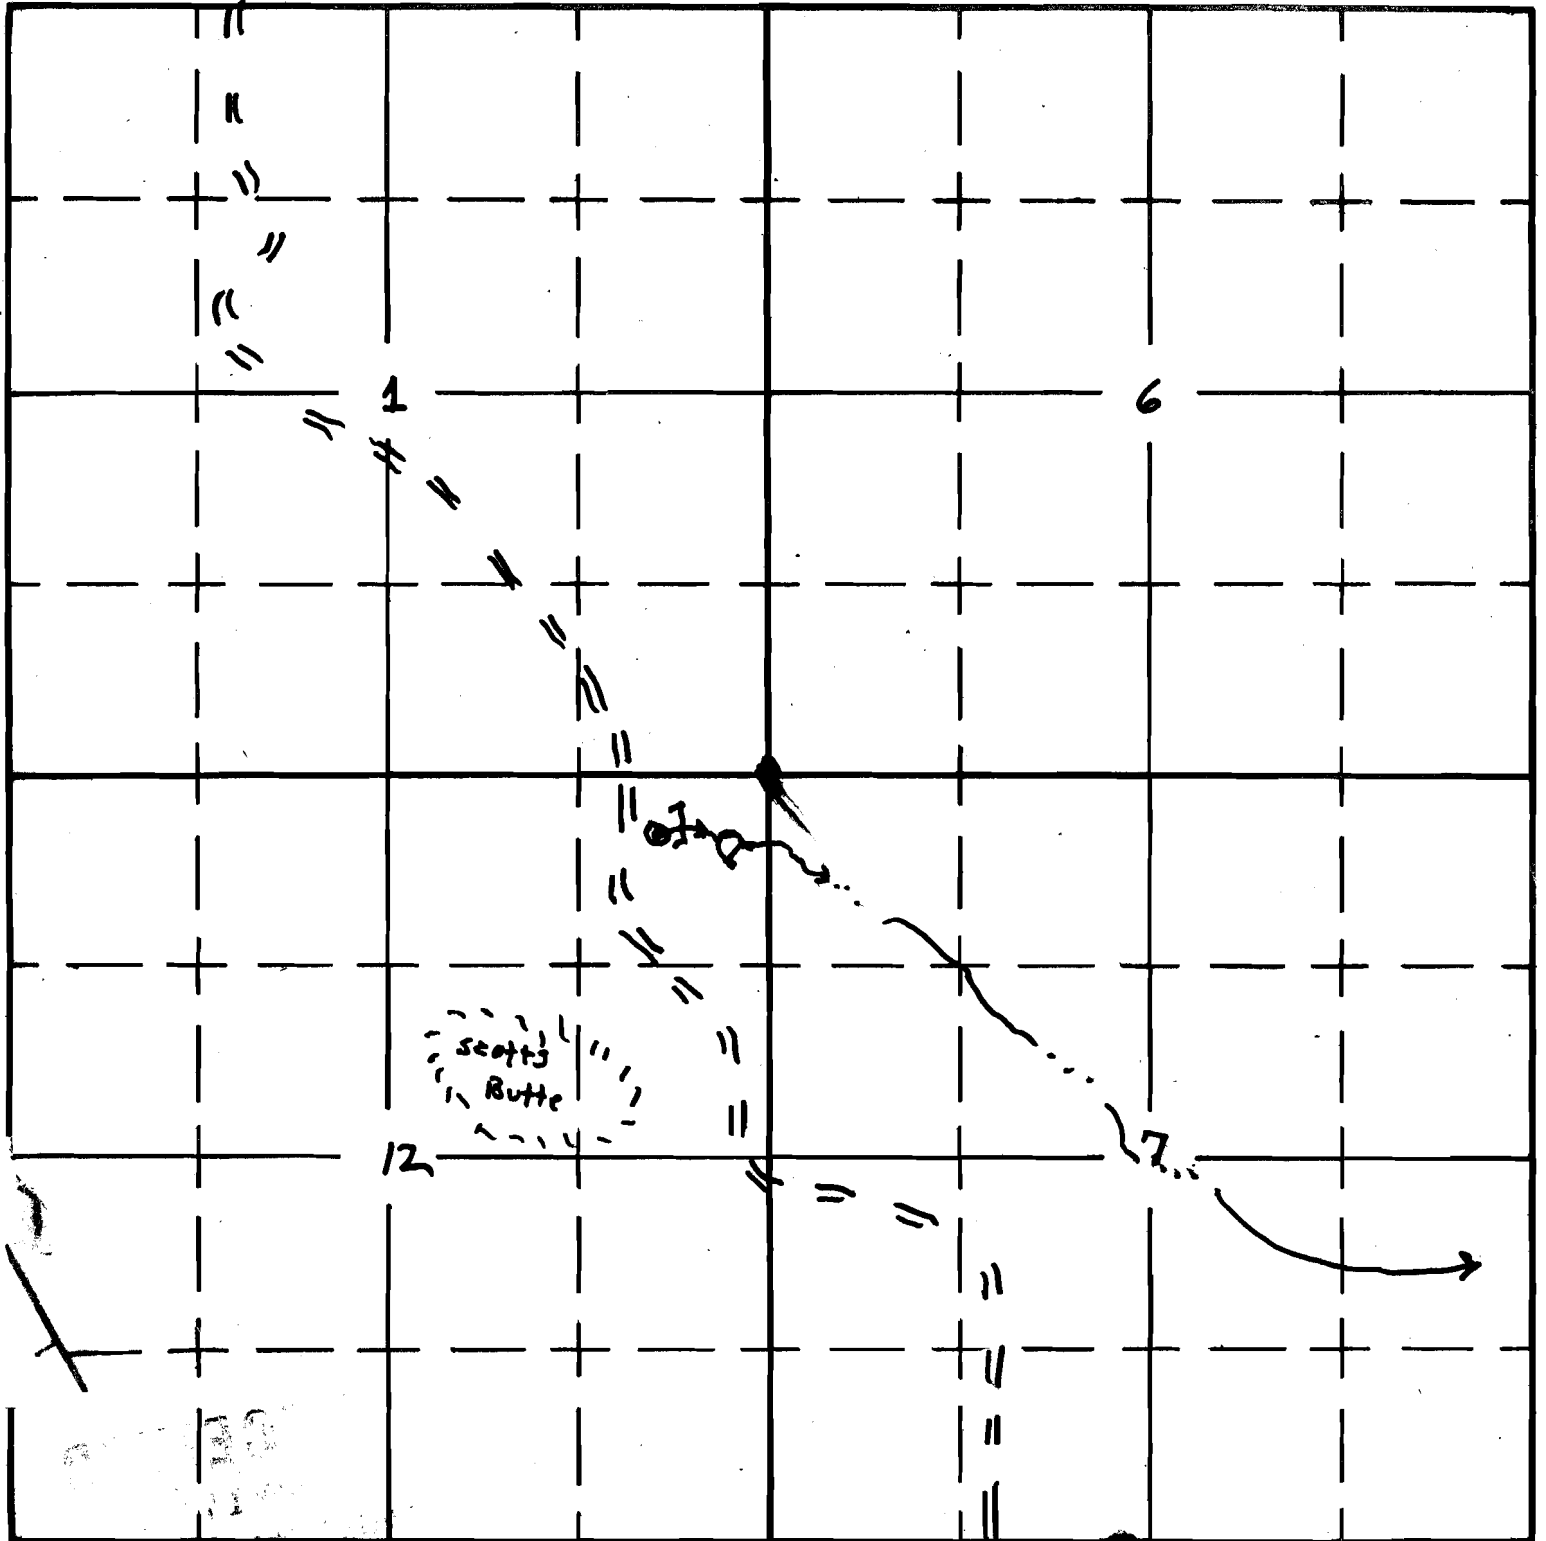

South

Application No. 66569  
Permit No. 50791

RECEIVED  
SEP 1 1983  
NATURAL RESOURCES DEPT.  
OREGON